

STATE ENGINEER  
Salem, Oregon

LINN  
10644

# Well Record

STATE WELL NO. 12/4W-8E  
COUNTY Linn  
APPLICATION NO. CR-3782

OWNER: Gluda V. Wood


MAILING ADDRESS: Route 4, Box 355

LOCATION OF WELL: Owner's No. \_\_\_\_\_

CITY AND STATE: Corvallis, Oregon

SW 1/4 NW 1/4 Sec. 8 T. 12 S., R. 4 W., W.M.

Bearing and distance from section or subdivision corner 1914' S. & 1089' E. of NW Cor. Sec. 8

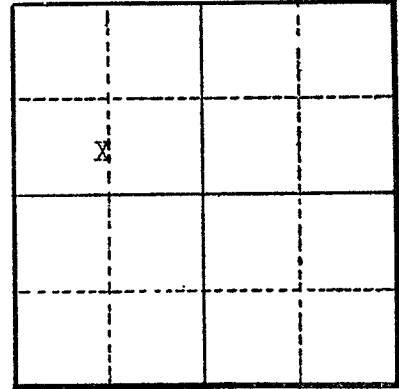

Section 8

Altitude at well \_\_\_\_\_

TYPE OF WELL: Drilled Date Constructed 1953

Depth drilled 31 feet Depth cased 31 feet

### CASING RECORD:

6 inch steel casing set to 31 feet

### FINISH:

### AQUIFERS:

### WATER LEVEL:

PUMPING EQUIPMENT: Type Fairbanks Morse 2" centrifugal H.P. 5  
Capacity 100 G.P.M.

### WELL TESTS:

Drawdown \_\_\_\_\_ ft. after \_\_\_\_\_ hours \_\_\_\_\_ G.P.M.  
Drawdown \_\_\_\_\_ ft. after \_\_\_\_\_ hours \_\_\_\_\_ G.P.M.

USE OF WATER Irrigation Temp. \_\_\_\_\_ °F., 19\_\_\_\_

SOURCE OF INFORMATION Well Registration Statement

DRILLER or DIGGER \_\_\_\_\_

### ADDITIONAL DATA:

Log \_\_\_\_\_ Water Level Measurements \_\_\_\_\_ Chemical Analysis \_\_\_\_\_ Aquifer Test \_\_\_\_\_

### REMARKS: