

STATE ENGINEER
Salem, Oregon

LINN
10646

Well Record

STATE WELL NO. 12/4W-8F
COUNTY Linn
APPLICATION NO. GR-203

OWNER: Wm. D. Heatherington

MAILING ADDRESS: Route 4, Box 352-A

LOCATION OF WELL: Owner's No. _____

CITY AND STATE: Corvallis, Oregon


SE 1/4 SW 1/4 Sec. 8 T. 12 S., R. 4 W., W.M.

Bearing and distance from section or subdivision corner _____

Altitude at well _____

TYPE OF WELL: Drilled Date Constructed 1945

Depth drilled 50 Depth cased _____

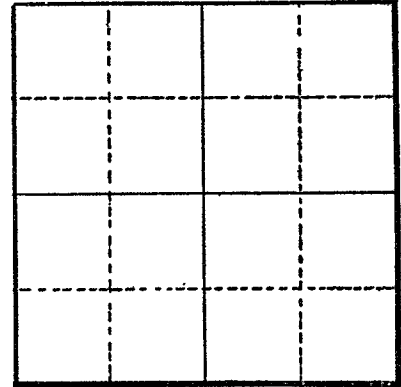

Section 8

CASING RECORD:

Unknown

FINISH:

Unknown

AQUIFERS:

Unknown

WATER LEVEL:

9 feet

PUMPING EQUIPMENT: Type Fairbanks Morse 8 inch centrifugal H.P. 3
Capacity 60 G.P.M.

WELL TESTS:

Drawdown _____ ft. after _____ hours _____ G.P.M.
Drawdown _____ ft. after _____ hours _____ G.P.M.

USE OF WATER Irrigation Temp. _____ °F., 19 _____

SOURCE OF INFORMATION GR-203

DRILLER or DIGGER Stapleton Bros.

ADDITIONAL DATA:

Log _____ Water Level Measurements _____ Chemical Analysis _____ Aquifer Test _____

REMARKS: