

STATE ENGINEER
Salem, Oregon

LINN
10689

Well Record


STATE WELL NO. 12/LW-9B
COUNTY Linn
APPLICATION NO.

OWNER: Orville O. or Bonnie G. Doerfler MAILING ADDRESS: Rt. 3, Box 863

LOCATION OF WELL: Owner's No. 2 CITY AND STATE: Albany, Oregon

NW 1/4 NE 1/4 Sec. 9 T. 12 S. R. 4 W., W.M.

Bearing and distance from section or subdivision
corner S. 80° 40' 22 chs. from NE cor. Sec. 9

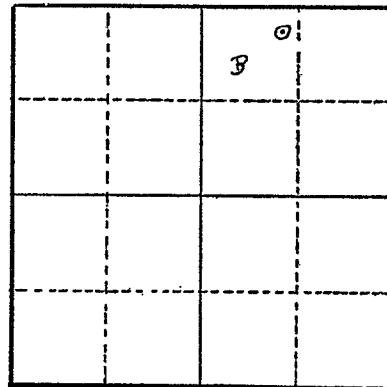

Altitude at well 215 ft.

TYPE OF WELL: drilled Date Constructed 1947

Depth drilled 70 ft. Depth cased

Section 9

CASING RECORD: 4 in. steel 0 to 70 ft.

FINISH: Slot perforations 60 to 70 ft.

AQUIFERS:

WATER LEVEL: 7 ft.

PUMPING EQUIPMENT: Type deep well turbine H.P. 3/4 elec.
Capacity 25 G.P.M.

WELL TESTS:
Drawdown 15 ft. after hours 25 (est) G.P.M.
Drawdown ft. after hours G.P.M.

USE OF WATER irrigation Temp. °F. 19

SOURCE OF INFORMATION

DRILLER or DIGGER Slate Drilling Co., Tangent, Oregon

ADDITIONAL DATA:

Log Water Level Measurements Chemical Analysis Aquifer Test

REMARKS: