

STATE ENGINEER
Salem, Oregon

LINN Well Record
10712

STATE WELL NO. 12/4W-12B
COUNTY Linn
APPLICATION NO. GR-3214

OWNER: Lloyd and Anabelle Forster


MAILING ADDRESS: Tangent,

LOCATION OF WELL: Owner's No.

CITY AND STATE: Oregon

NW 1/4 NE 1/4 Sec. 12 T. 12 S. R. 4 W., W.M.

Bearing and distance from section or subdivision
corner 264 feet S. and 2871 feet E. of the
N. E. Corner of Section 12

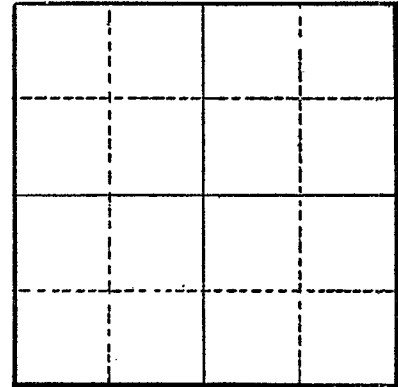

Altitude at well

TYPE OF WELL: drilled Date Constructed 1946

Depth drilled 96 feet Depth cased 96 feet

Section

CASING RECORD:

8-inch

FINISH:

Slot perforations from 50 to 96

AQUIFERS:

WATER LEVEL:

22 feet

PUMPING EQUIPMENT: Type Berkeley Deep Well H.P. 5
Capacity 150 G.P.M.

WELL TESTS:
Drawdown 18 ft. after hours Pumping 440 G.P.M.
Drawdown ft. after hours G.P.M.

USE OF WATER Irrigation Temp. °F. 19

SOURCE OF INFORMATION GR-2991

DRILLER or DIGGER Slate Drilling Company, Tangent, Oregon

ADDITIONAL DATA:

Log Water Level Measurements Chemical Analysis Aquifer Test

REMARKS: