

STATE ENGINEER
Salem, Oregon

LINN
10713

Well Record


STATE WELL NO. 12/4W-12J
COUNTY LINN
APPLICATION NO. GR-2403

OWNER: Leaburn C. and Lenora F. Harrison MAILING ADDRESS: Route 1.

LOCATION OF WELL: Owner's No. CITY AND STATE: Tangent, Oregon

NE 1/4 SE 1/4 Sec. 12 T. 12 S., R. 4 W., W.M.

Bearing and distance from section or subdivision corner 2211' N. and 264' W.

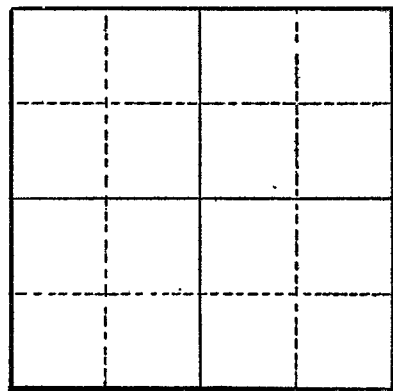

Section

Altitude at well

TYPE OF WELL: Drilled Date Constructed 1954

Depth drilled 60 Depth cased 55

CASING RECORD:

8-inch

FINISH:

Slot perforations from 30 to 55

AQUIFERS:

WATER LEVEL:

35-feet

PUMPING EQUIPMENT: Type Pomona Fairbanks Morse H.P. 15
Capacity 500 G.P.M.

WELL TESTS:

Drawdown ft. after hours G.P.M.
Drawdown ft. after hours G.P.M.

USE OF WATER Irrigation Temp. °F. 19

SOURCE OF INFORMATION GR-2284

DRILLER or DIGGER Art Schaffer, Philomath, Oregon

ADDITIONAL DATA:

Log Water Level Measurements Chemical Analysis Aquifer Test

REMARKS: