

STATE ENGINEER
Salem, Oregon

LINN
10734

Well Record

STATE WELL NO. 12/LW-16G(1)
COUNTY Linn
APPLICATION NO. GR-708

OWNER: L. A. Hammond

MAILING

ADDRESS: Rt. 3, Box 856

LOCATION OF WELL: Owner's No.

CITY AND


STATE: Albany, Oregon

SW 1/4 NE 1/4 Sec. 16 T. 12 N. S., R. 4 E. W., W.M.

Bearing and distance from section or subdivision

corner N. 46° 30' E. 9.3 chs. from SW cor. David

Erwin DLG 55

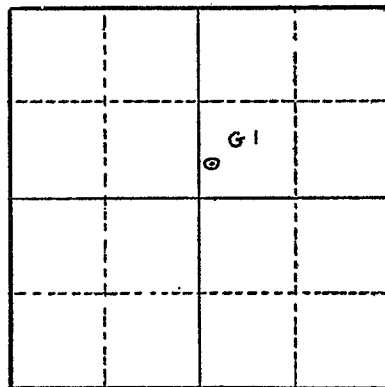

Altitude at well 241 ft. Interpolated

TYPE OF WELL: drilled Date Constructed 1949

Depth drilled 90 ft. Depth cased 90 ft.

Section 16

CASING RECORD:

6 inch

FINISH:

AQUIFERS:

WATER LEVEL: 10 ft.

PUMPING EQUIPMENT: Type Fairbanks Morse H.P. 3
Capacity 100 G.P.M.

WELL TESTS:

Drawdown 25 ft. after 61 hours G.P.M.

Drawdown ft. after hours G.P.M.

USE OF WATER irrigation 14.9 acres Temp. °F. 19

SOURCE OF INFORMATION GR-708

DRILLER or DIGGER Bud Slate; Tangent, Oregon

ADDITIONAL DATA:

Log ☒ Water Level Measurements ☐ Chemical Analysis ☐ Aquifer Test

REMARKS: