

STATE ENGINEER
Salem, Oregon

LINN
10754

Well Record


STATE WELL NO. 12/LW-17E(1)
COUNTY Linn
APPLICATION NO. GR-527

OWNER: F. M. or Floy Lamb MAILING ADDRESS: Rt. 3

LOCATION OF WELL: Owner's No. CITY AND STATE: Albany, Oregon

SW 1/4 NW 1/4 Sec. 17 T. 12 N. S., R. 4 E. W., W.M.

Bearing and distance from section or subdivision
corner N. 69° E. 16.75 chs. from most northerly
NE cor. DLC 50

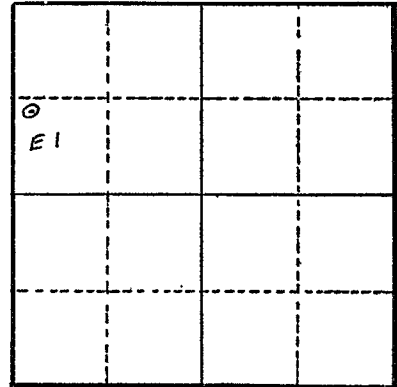

Section 17

Altitude at well 225 ft.

TYPE OF WELL: drilled Date Constructed 9/10/54

Depth drilled 47 ft. Depth cased 47 ft.

CASING RECORD: 10 inch

FINISH:

AQUIFERS:

WATER LEVEL: 18 ft.

PUMPING EQUIPMENT: Type Palma centrifugal H.P. 10
Capacity 250 G.P.M.

WELL TESTS:
Drawdown 10 ft. after 220 hours G.P.M.
Drawdown ft. after hours G.P.M.

USE OF WATER irrigation 29.5 acres Temp. °F. 19

SOURCE OF INFORMATION GR-527

DRILLER or DIGGER Schaeffer; Philomath, Oregon

ADDITIONAL DATA:
Log Water Level Measurements Chemical Analysis Aquifer Test

REMARKS: