

STATE ENGINEER
Salem, Oregon

LINN
10784

Well Record

STATE WELL NO. 12/4W-27M(1)
COUNTY Linn
APPLICATION NO. GR-586


OWNER: Harlan P. Iverson
MAILING ADDRESS: Rt. 1

LOCATION OF WELL: Owner's No.
CITY AND STATE: Shedd, Oregon

NW 1/4 SW 1/4 Sec. 27 T. 12 S., R. 4 W., W.M.

Bearing and distance from section or subdivision

corner S. 74° 15' E. 9.5 chs. from NW cor. SW 1/4
Sec. 27

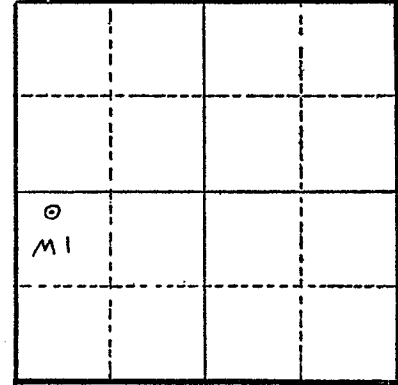

Altitude at well 252 ft.

TYPE OF WELL: drilled Date Constructed April 1950

Depth drilled 94 ft. Depth cased 94 ft.

Section 27

CASING RECORD: 10 inch

FINISH:

AQUIFERS:

WATER LEVEL: 15 ft.

PUMPING EQUIPMENT: Type Fairbanks Morse turbine H.P. 7 1/2
Capacity 150 G.P.M.

WELL TESTS:
Drawdown 20 ft. after hours 200 G.P.M.
Drawdown ft. after hours G.P.M.

USE OF WATER irrigation 28.4 acres Temp. °F. 19

SOURCE OF INFORMATION GR-586

DRILLER or DIGGER

ADDITIONAL DATA:

Log Water Level Measurements Chemical Analysis Aquifer Test

REMARKS: