

STATE ENGINEER
Salem, Oregon

LINN
10812

Well Record

STATE WELL NO. 12/4W-34E
COUNTY LINN
APPLICATION NO. GR-2529

OWNER: Rolland Lamp


MAILING ADDRESS: Route 1

LOCATION OF WELL: Owner's No.

CITY AND STATE: Shedd, Oregon

SW 1/4 NW 1/4 Sec. 34 T. 12 N S., R. 4 E W., W.M.

Bearing and distance from section or subdivision corner 2376' S. & 891' E.

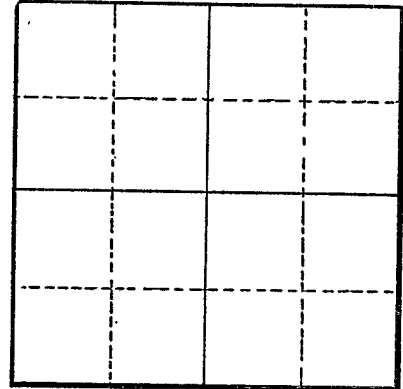

Section

Altitude at well

TYPE OF WELL: Drilled Date Constructed 1954

Depth drilled 121 Depth cased 121

CASING RECORD:

8-inch

FINISH:

Slot perforations from 106 to 115

AQUIFERS:

WATER LEVEL:

27-feet

PUMPING EQUIPMENT: Type Fairbanks Morse Turbine H.P. 5
Capacity 250 G.P.M.

WELL TESTS:

Drawdown 80 ft. after hours Pumping 385 G.P.M.

Drawdown ft. after hours G.P.M.

USE OF WATER Irrigation Temp. °F., 19

SOURCE OF INFORMATION GR-2391

DRILLER or DIGGER T. J. Burkhart, Albany, Oregon

ADDITIONAL DATA:

Log Water Level Measurements Chemical Analysis Aquifer Test

REMARKS: