

STATE ENGINEER  
Salem, Oregon

**LINN** Well Record  
10814

STATE WELL NO. 12/14-34K  
COUNTY Linn  
APPLICATION NO. GR-3656

OWNER: Glen R. Hawkins

MAILING  
ADDRESS:

LOCATION OF WELL: Owner's No.


CITY AND  
STATE:

Shedd, Oregon

NW  $\frac{1}{4}$  SE  $\frac{1}{4}$  Sec. 34 T. 12 S., R. 4 W., W.M.

Bearing and distance from section or subdivision

corner 584' N. & 2409' W. of SE cor. Sec. 34

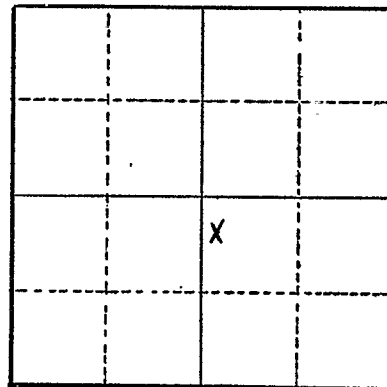

Altitude at well

TYPE OF WELL: Drilled Date Constructed Jan., 1952

Depth drilled 88 ft. Depth cased 88 ft.

Section 34

CASING RECORD:

8 inch casing set to 88 feet

FINISH:

38 perforations per foot 2" x 3/4" from 69 ft. to 88 ft.

AQUIFERS:

WATER LEVEL:

17 feet below surface

PUMPING EQUIPMENT: Type Berkely turbine H.P. 5  
Capacity 120 G.P.M.

WELL TESTS:

Drawdown 27 ft. after 320 hours G.P.M.

The above figure was full capacity of test pump.  
Drawdown        ft. after        hours G.P.M.

USE OF WATER Irrigation Temp.        °F., 19

SOURCE OF INFORMATION Well Registration Statement

DRILLER or DIGGER

ADDITIONAL DATA:

Log X Water Level Measurements        Chemical Analysis        Aquifer Test       

REMARKS:

State Well No. 12/4W-34K.....

County Linn

Application No. GR-3656

# Well Log

Owner: Glen R. Hawkins Owner's No.                     

Driller: \_\_\_\_\_ Date Drilled January, 1952

[illegible]