

STATE ENGINEER
Salem, Oregon

LINN
10815

Well Record

GR- 1020

STATE WELL NO. 12/4W-34L(1)
COUNTY Linn
APPLICATION NO. GR- 1058

OWNER: James E. Barton


MAILING ADDRESS: 3741 Y St.

LOCATION OF WELL: Owner's No.

CITY AND STATE: Sacramento, California

NE 1/4 SW 1/4 Sec. 34 T. 12 S., R. 4 W., W.M.

Bearing and distance from section or subdivision
corner S85°45'E. 30.75 ch. from NW cor. of DIC #44.

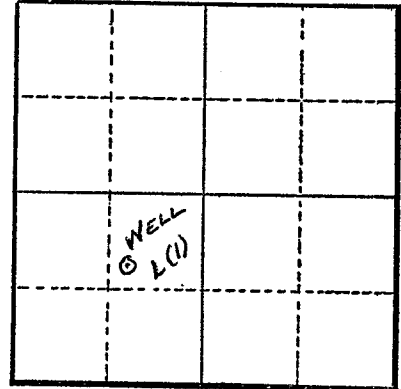

Section 34

Altitude at well 257 ft.

TYPE OF WELL: Drilled Date Constructed 1954

Depth drilled 85 ft. Depth cased 85 ft.

CASING RECORD:

6 inch

FINISH:

Slot perforations from 79 to 85 ft.

AQUIFERS:

WATER LEVEL:

12 ft.

PUMPING EQUIPMENT: Type F. M. Deep Well H.P. 1
Capacity 50 G.P.M.

WELL TESTS:

Drawdown ft. after hours G.P.M.
Drawdown ft. after hours G.P.M.

USE OF WATER Irrigation Temp. °F. 19

SOURCE OF INFORMATION G.R. Record

DRILLER or DIGGER Slate Drilling Co.

ADDITIONAL DATA:

Log N.A. Water Level Measurements Chemical Analysis Aquifer Test

REMARKS:

Irrigation of 4.1 acres.