

STATE ENGINEER
Salem, Oregon

LINN
10827

Well Record

STATE WELL NO. 12/44-36L
COUNTY LINN
APPLICATION NO. GR-2772

OWNER: Otto Leigh Swarthout

MAILING ADDRESS: Tangent,


LOCATION OF WELL: Owner's No.

CITY AND STATE: Oregon

NE 1/4 SW 1/4 Sec. 36 T. 12 N. S. R. 4 E. W. W.M.

Bearing and distance from section or subdivision

corner 429' S. and 30' W.

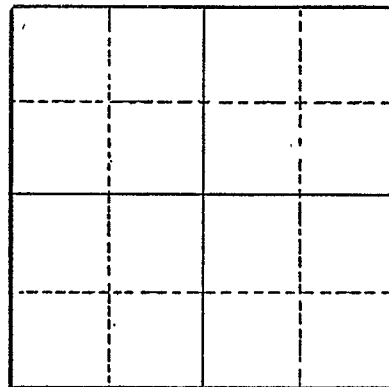

Section

Altitude at well

TYPE OF WELL: drilled Date Constructed 1951

Depth drilled 56 Depth cased 56

CASING RECORD:

6-inch

FINISH:

AQUIFERS:

WATER LEVEL:

PUMPING EQUIPMENT: Type Jacuzzi Turbine H.P. 5
Capacity 82 G.P.M.

WELL TESTS:

Drawdown 55 ft. after hours Pumping 82 G.P.M.

Drawdown ft. after hours G.P.M.

USE OF WATER irrigation Temp. °F. 19

SOURCE OF INFORMATION GR-2621

DRILLER or DIGGER Slate Well Drillers, Tangent, Oregon

ADDITIONAL DATA:

Log Water Level Measurements Chemical Analysis Aquifer Test

REMARKS: