

STATE ENGINEER
Salem, Oregon

LINN
10837

Well Record

GR- 1683

STATE WELL NO. 12/5W-1A
COUNTY Linn
APPLICATION NO. GR-1735

OWNER: Golda A. Porter

MAILING

ADDRESS: Rt. 4, Box 311

LOCATION OF WELL: Owner's No.


CITY AND

STATE: Corvallis, Oregon

NE 1/4 NE 1/4 Sec. 1 T. 12 S., R. 5 W., W.M.

Bearing and distance from section or subdivision

corner 132' S. & 1188' W. from NE cor. Sec. 1

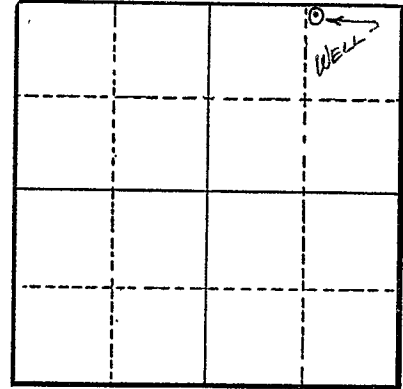

Section 1

Altitude at well 250'

TYPE OF WELL: Drilled Date Constructed 1946

Depth drilled 40' Depth cased 40'

CASING RECORD:

6"

FINISH:

Slot perforations from 30 to 40 ft.

AQUIFERS:

WATER LEVEL:

20 ft.

PUMPING EQUIPMENT: Type Deep well turbine

H.P. 3/4

Capacity 50 G.P.M.

WELL TESTS:

Drawdown ft. after hours G.P.M.

Drawdown ft. after hours G.P.M.

USE OF WATER Irrigation Temp. °F., 19

SOURCE OF INFORMATION GR Record

DRILLER or DIGGER Schaefer of Philomath

ADDITIONAL DATA:

Log N.A. Water Level Measurements Chemical Analysis Aquifer Test

REMARKS:

Irrigation of 2.5 acres.