

STATE ENGINEER
Salem, Oregon

LINN
10840

Well Record

STATE WELL NO. 12/5W-3B
COUNTY LINN
APPLICATION NO. GR-2527

OWNER: Thurza M. Russell

MAILING ADDRESS: Rt 4, Box 308


LOCATION OF WELL: Owner's No.

CITY AND STATE: Corvallis

NW 1/4 NE 1/4 Sec. 1 T. 12 S., R. 5 W., W.M.

Bearing and distance from section or subdivision

corner 480' S & 80' W of NW cor Pleasant Robinette
DLC

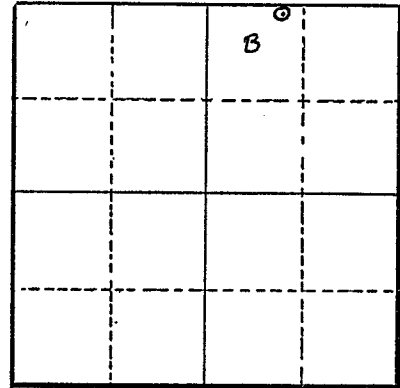

Section 3

Altitude at well

TYPE OF WELL: Drilled Date Constructed 1937

Depth drilled 40' Depth cased 40'

CASING RECORD:

6-inch

FINISH:

AQUIFERS:

WATER LEVEL:

PUMPING EQUIPMENT: Type Jacuzzi Jet H.P. 5
Capacity 100 G.P.M.

WELL TESTS:

Drawdown ft. after hours G.P.M.

Drawdown ft. after hours G.P.M.

USE OF WATER Irrigation Temp. °F., 19

SOURCE OF INFORMATION GR-3929

DRILLER or DIGGER Slate Well Drillers

ADDITIONAL DATA:

Log NA Water Level Measurements Chemical Analysis Aquifer Test

REMARKS: