

LINN
10844

Well Record

STATE WELL NO. 12/5W-1H
COUNTY Linn
APPLICATION NO. GR-3725

OWNER: George T. McLain


MAILING ADDRESS: Route 4, Box 371

LOCATION OF WELL: Owner's No.

CITY AND STATE: Corvallis, Oregon

SE 1/4 NE 1/4 Sec. 1 T. 12 S., R. 5 W., W.M.

Bearing and distance from section or subdivision corner 1762' S., 132' W. of NE cor. Sec. 1

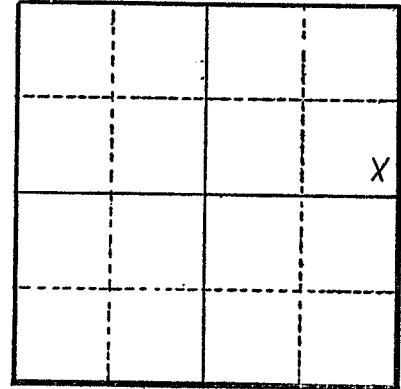

Section 1

Altitude at well

TYPE OF WELL: Drilled Date Constructed 9/8/52

Depth drilled 33 feet Depth cased 32 feet

CASING RECORD:

6 inch steel casing set to 32 feet

FINISH:

4 rows slotted perforations from 27 to 32 feet

AQUIFERS:

WATER LEVEL:

22 feet below surface

PUMPING EQUIPMENT: Type Myers Ejecto H.P. 1
Capacity 20 G.P.M.

WELL TESTS:

Drawdown ft. after hours G.P.M.

Drawdown ft. after hours G.P.M.

USE OF WATER Irrigation Temp. °F., 19

SOURCE OF INFORMATION Well Registration Statement

DRILLER or DIGGER C. A. Shafer

ADDITIONAL DATA:

Log Water Level Measurements Chemical Analysis Aquifer Test

REMARKS:

Log:

Clay
Hardpan
Gravel

Thickness	Depth to Bottom
14	14
7	21
11	32