

STATE ENGINEER
Salem, Oregon

LINN
11158

Well Record

STATE WELL NO. 13/1W-14M
COUNTY Linn
APPLICATION NO. GR-3965

OWNER: David & Mary Bowman

MAILING

ADDRESS: Box 775


LOCATION OF WELL: Owner's No.

CITY AND

STATE: Foster, Oregon

NW 1/4 SW 1/4 Sec. 14 T. 13 N. S., R. 1 E. W., W.M.

Bearing and distance from section or subdivision
corner 2376' N. & 1254' E. of SW 1/4 of Sec. 14

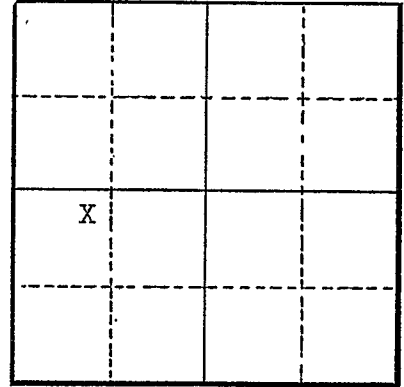

Section 14

Altitude at well

TYPE OF WELL: Dug Date Constructed June, 1955

Depth drilled 37 ft. Depth cased 37 ft.

CASING RECORD:

4 feet diameter concrete from 0 to 37 feet

FINISH:

AQUIFERS:

WATER LEVEL:

20 feet below surface

PUMPING EQUIPMENT: Type Montgomery Ward jet H.P. 1/4
Capacity 25 G.P.M.

WELL TESTS:

Drawdown ft. after hours G.P.M.

Drawdown ft. after hours G.P.M.

USE OF WATER Irrigation Temp. °F., 19

SOURCE OF INFORMATION Well Registration Statement Cert. # GR-3583

DRILLER or DIGGER David Bowman

ADDITIONAL DATA:

Log Water Level Measurements Chemical Analysis Aquifer Test

REMARKS: