

STATE ENGINEER  
Salem, Oregon

**LINN**  
**1159**


# Well Record

STATE WELL NO. 13/1W-14M  
COUNTY Linn  
APPLICATION NO. GR-3964

OWNER: Boyd & Nellie J. McCoy MAILING ADDRESS: Route 1, Box 3363

LOCATION OF WELL: Owner's No. \_\_\_\_\_ CITY AND STATE: Sweet Home, Oregon

NW  $\frac{1}{4}$  SW  $\frac{1}{4}$  Sec. 14 T. 13 S., R. 1 W., W.M.  
Bearing and distance from section or subdivision  
corner 1650' N. & 1254' E. of SW $\frac{1}{4}$  of Sec. 14

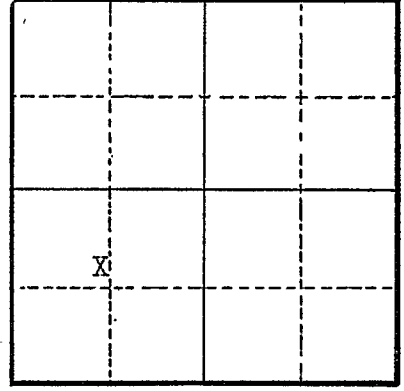

Section 14

Altitude at well \_\_\_\_\_

TYPE OF WELL: Dug Date Constructed 1953  
Depth drilled 25 ft. Depth cased 25 ft.

### CASING RECORD:

8' x 8' lumber casing set to 25 feet

### FINISH:

### AQUIFERS:

### WATER LEVEL:

20 feet below surface

PUMPING EQUIPMENT: Type Montgomery Ward jet H.P.  $\frac{1}{2}$   
Capacity 25 G.P.M.

### WELL TESTS:

Drawdown \_\_\_\_\_ ft. after \_\_\_\_\_ hours \_\_\_\_\_ G.P.M.  
Drawdown \_\_\_\_\_ ft. after \_\_\_\_\_ hours \_\_\_\_\_ G.P.M.

USE OF WATER Irrigation Temp. \_\_\_\_\_ °F., 19 \_\_\_\_\_  
SOURCE OF INFORMATION Well Registration Statement Cert. # GR-3580

DRILLER or DIGGER Boyd McCoy

### ADDITIONAL DATA:

Log \_\_\_\_\_ Water Level Measurements \_\_\_\_\_ Chemical Analysis \_\_\_\_\_ Aquifer Test \_\_\_\_\_

### REMARKS: