

LINN
11195

Well Record


STATE WELL NO. 13/IW-15H
COUNTY LINN
APPLICATION NO. GR-2743

OWNER: Ed Kellenberger Kell Lumber Co. MAILING ADDRESS: Rt. 1, Box 3272

LOCATION OF WELL: Owner's No. CITY AND STATE: Sweet Home, Oregon

SE 1/4 NE 1/4 Sec. 15 T. 13 S., R. 1 W., W.M.

Bearing and distance from section or subdivision corner 580' N. and 460' W.

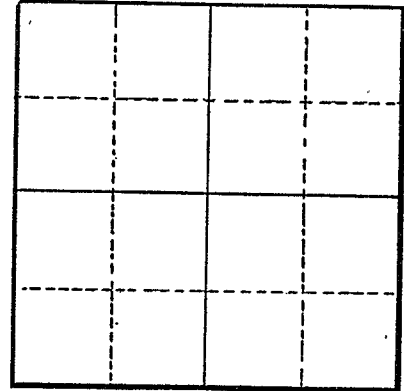

Section

Altitude at well

TYPE OF WELL: drilled Date Constructed 1947

Depth drilled 28-30 Depth cased

CASING RECORD:

8-inch

FINISH:

Perforated

AQUIFERS:

WATER LEVEL:

11-feet

PUMPING EQUIPMENT: Type Jacuzzi Pump Capacity G.P.M. H.P.

WELL TESTS:

Drawdown ft. after hours G.P.M.
Drawdown ft. after hours G.P.M.

USE OF WATER irrigation & manu. Temp. °F., 19.....
SOURCE OF INFORMATION GR-2595

DRILLER or DIGGER

ADDITIONAL DATA:

Log Water Level Measurements Chemical Analysis Aquifer Test

REMARKS: