

STATE ENGINEER  
Salem, Oregon

LINN  
1196

# Well Record

STATE WELL NO. 13/1W-15H  
COUNTY LINN  
APPLICATION NO. GR-2742


OWNER: Ed Kallenberger, Kell Lumber Co. MAILING ADDRESS: Rt. 1, Box 3272

LOCATION OF WELL: Owner's No. CITY AND STATE: Sweet Home, Oregon

SE 1/4 NE 1/4 Sec. 15 T. 13 S., R. 1 W., W.M.

Bearing and distance from section or subdivision

corner 300' N. and 400' W.

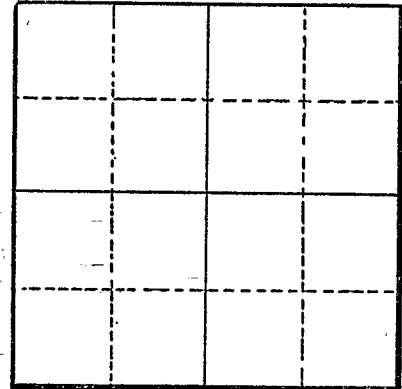

Section

Altitude at well

TYPE OF WELL: drilled Date Constructed 1947

Depth drilled 84 Depth cased 40

### CASING RECORD:

8-inch

### FINISH:

### AQUIFERS:

### WATER LEVEL:

20-feet

PUMPING EQUIPMENT: Type Jacuzzi Submersible H.P. 5  
Capacity G.P.M.

### WELL TESTS:

Drawdown ft. after hours G.P.M.

Drawdown ft. after hours G.P.M.

USE OF WATER manufacturing, industrial Temp. °F., 19

SOURCE OF INFORMATION GR-2594

DRILLER or DIGGER

### ADDITIONAL DATA:

Log Water Level Measurements Chemical Analysis Aquifer Test

### REMARKS: