


LINN
11197

Well Record

STATE WELL NO. 13/1W-15H
COUNTY LINN
APPLICATION NO. GR-2741

OWNER: Ed Kellenberger Kell Lumber Co. MAILING ADDRESS: Rt. 1, Box 3272
LOCATION OF WELL: Owner's No. CITY AND STATE: Sweet Home, Oregon

SE 1/4 NE 1/4 Sec. 15 T. 13 S. R. 1 W., W.M.
Bearing and distance from section or subdivision corner 960' W. and 810' N.

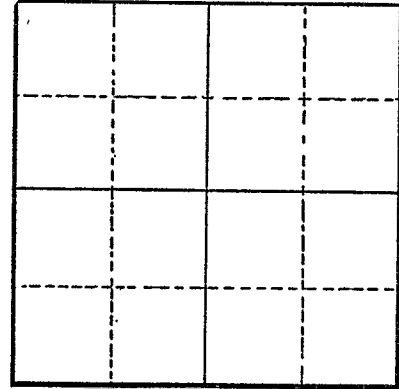

Altitude at well

TYPE OF WELL: drilled Date Constructed 1940
Depth drilled 110 Depth cased

Section

CASING RECORD:

8-inch

FINISH:

AQUIFERS:

WATER LEVEL:

20-feet

PUMPING EQUIPMENT: Type Jacuzzi Jet H.P. 3
Capacity 50 G.P.M.

WELL TESTS:

Drawdown ft. after hours G.P.M.
Drawdown ft. after hours G.P.M.

USE OF WATER manufacturing Temp. °F. 19

SOURCE OF INFORMATION GR-2593

DRILLER or DIGGER

ADDITIONAL DATA:

Log Water Level Measurements Chemical Analysis Aquifer Test

REMARKS: