

STATE ENGINEER
Salem, Oregon

LINN
11309

Well Record

STATE WELL NO. 13/1W-23G
COUNTY Linn
APPLICATION NO. GR-3803

OWNER: Joe E. Miller

MAILING

ADDRESS: 1078 40th

LOCATION OF WELL: Owner's No.


CITY AND

STATE: Ogden, Utah

SW 1/4 NE 1/4 Sec. 23 T. 13 S. R. 1 W., W.M.

Bearing and distance from section or subdivision

corner 2600' S. & 1716' W. of NW Cor. of Sec. 23

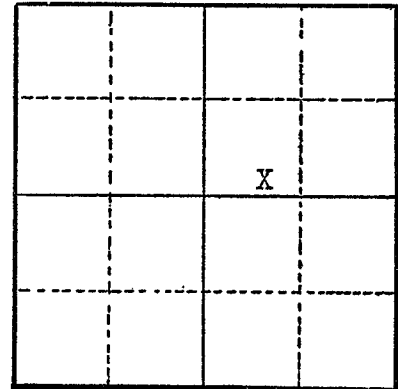

Section 23

Altitude at well

TYPE OF WELL: Drilled Date Constructed June, 1952

Depth drilled 41 feet Depth cased 41 feet

CASING RECORD:

10 inch steel casing set to 41 feet

FINISH:

Slot perforations from 22 to 41 feet

AQUIFERS:

WATER LEVEL:

22 feet below surface

PUMPING EQUIPMENT: Type 2" centrifugal H.P. 10
Capacity 200 G.P.M.

WELL TESTS:

Drawdown ft. after hours G.P.M.

Drawdown ft. after hours G.P.M.

USE OF WATER Irrigation Temp. °F. 19

SOURCE OF INFORMATION Well Registration Statement

DRILLER or DIGGER

ADDITIONAL DATA:

Log Water Level Measurements Chemical Analysis Aquifer Test

REMARKS: