

STATE ENGINEER
Salem, Oregon

LINN
11574

Well Record

STATE WELL NO. 13/2W-5B
COUNTY Linn
APPLICATION NO. GR-3447

OWNER: C. C. McBride

MAILING ADDRESS: Route 2, Box 73


LOCATION OF WELL: Owner's No.

CITY AND STATE: Lebanon, Oregon

NW 1/4 NE 1/4 Sec. 5 T. 13 N. 2 E. S., R. W., W.M.

Bearing and distance from section or subdivision

corner 726' S. and 3069' E.

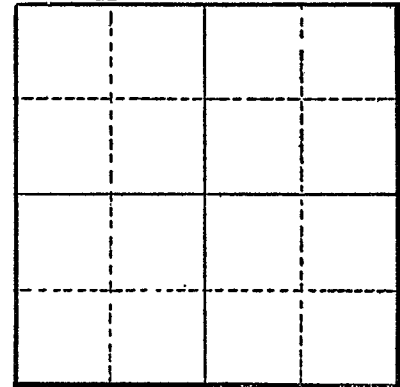

Section

Altitude at well

TYPE OF WELL: drilled Date Constructed 1951

Depth drilled 63' Depth cased 40'

CASING RECORD:

6"

FINISH:

slot perforations from 18 to 40

AQUIFERS:

WATER LEVEL:

8'

PUMPING EQUIPMENT: Type Gould 1 1/4" Cent. H.P. 3
Capacity 50 G.P.M.

WELL TESTS:

Drawdown 30 ft. after hours pumping 50 G.P.M.

Drawdown ft. after hours G.P.M.

USE OF WATER Irrigation Temp. °F. 19

SOURCE OF INFORMATION GR-3188

DRILLER or DIGGER Shaffer and Gallatley Philomath, Oregon

ADDITIONAL DATA:

Log Water Level Measurements Chemical Analysis Aquifer Test

REMARKS: