

STATE ENGINEER
Salem, Oregon

LINN
11659

Well Record

STATE WELL NO. 13/2N - 19H
COUNTY LINN
APPLICATION NO. GR-2245

OWNER: Henry and Mabel Weger


MAILING
ADDRESS: Route 1.

LOCATION OF WELL: Owner's No.

CITY AND
STATE: Brownsville, Oregon

SE 1/4 NE 1/4 Sec. 19 T. 13 N. S. R. 2 W., W.M.

Bearing and distance from section or subdivision
corner 1452' S. and 957' W.

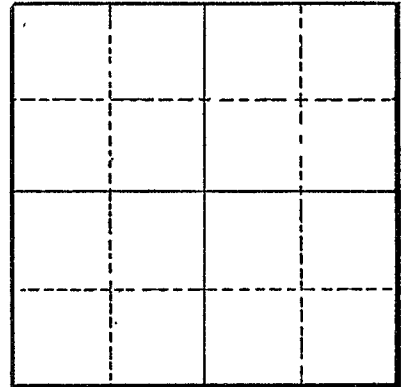

Altitude at well

TYPE OF WELL Drilled Date Constructed 1948

Depth drilled 53 Depth cased 49

Section

CASING RECORD:

5-Inch

FINISH:

Perforations from 35 to 49

AQUIFERS:

WATER LEVEL:

5-Feet

PUMPING EQUIPMENT: Type Fairbanks Morse Piston H.P. 1
Capacity 25 G.P.M.

WELL TESTS:

Drawdown ft. after hours G.P.M.
Drawdown ft. after hours G.P.M.

USE OF WATER Irrigation Temp. °F. 19

SOURCE OF INFORMATION GR-2146
DRILLER or DIGGER Ruckert, Lebanon, Oregon

ADDITIONAL DATA:

Log Water Level Measurements Chemical Analysis Aquifer Test

REMARKS: