

STATE ENGINEER
Salem, Oregon

LINN
11765

Well Record

STATE WELL NO. 13/2W-3LP(1)
COUNTY Linn
APPLICATION NO. GR-12

OWNER: City of Brownsville


MAILING ADDRESS: City Hall

LOCATION OF WELL: Owner's No. 1

CITY AND STATE: Brownsville, Oregon

SE 1/4 SW 1/4 Sec. 31 T. 13 N. S., R. 2 E., W.M.

Bearing and distance from section or subdivision corner 22 chs. E. & 19 chs. N. SW cor. Sec. 31

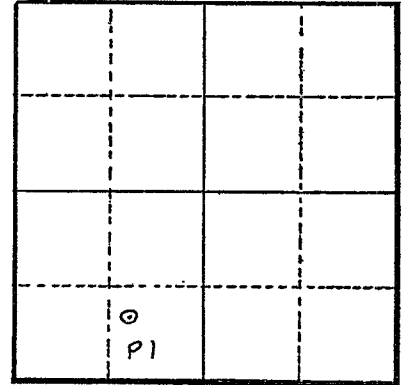

Section 31

Altitude at well 305 ft. Interpolated

TYPE OF WELL: dug Date Constructed 1921

Depth drilled 24 ft. Depth cased 24 ft.

CASING RECORD: Concrete pipe set from 0 to 24 ft.

FINISH: none

AQUIFERS: Gravel, from 8 to 24 ft.

WATER LEVEL: 18 ft. below land surface 1951

PUMPING EQUIPMENT: Type Fairbanks Morse H.P. 20
Capacity 225 G.P.M.

WELL TESTS:
Drawdown 2 ft. after 500 hours G.P.M.
Drawdown ft. after hours G.P.M.

USE OF WATER municipal 250 gpm Temp. °F. 19

SOURCE OF INFORMATION Reg. St. GR-12

DRILLER or DIGGER

ADDITIONAL DATA:

Log Water Level Measurements Chemical Analysis Aquifer Test

REMARKS: