

STATE ENGINEER
Salem, Oregon

LINN
11820

Well Record

STATE WELL NO. 13/3W-7J(1)
COUNTY Linn
APPLICATION NO. GR-947

OWNER: James C. and Eileen A. Cade


MAILING ADDRESS: Rt. 1, Box 129

LOCATION OF WELL: Owner's No.

CITY AND STATE: Shedd, Oregon

NE 1/4 SE 1/4 Sec. 7 T. 13 S., R. 3 W., W.M.

Bearing and distance from section or subdivision
corner S. 82° 30' W. 15.75 chs. from NE cor.
SE 1/4 Sec. 7

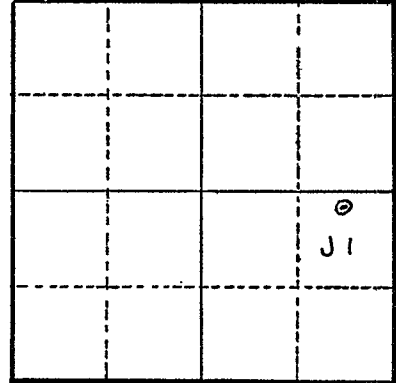

Section 7

Altitude at well 260 ft.

TYPE OF WELL: drilled Date Constructed 1950

Depth drilled 48 ft. Depth cased 48 ft.

CASING RECORD: 8 in. steel 0 to 48 ft.

FINISH: Slot perforations 46 to 48 ft.

AQUIFERS:

WATER LEVEL: 8 ft.

PUMPING EQUIPMENT: Type Fairbanks Morse 1" centrifugal H.P. 5 elec.
Capacity 150 G.P.M.

WELL TESTS:
Drawdown 45 ft. after 150 hours G.P.M.
Drawdown ft. after hours G.P.M.

USE OF WATER irrigation Temp. °F., 19

SOURCE OF INFORMATION owner

DRILLER or DIGGER Bill Hamilton; 838 E. 3rd Ave., Albany, Oregon

ADDITIONAL DATA:
Log Water Level Measurements Chemical Analysis Aquifer Test

REMARKS: