

STATE ENGINEER
Salem, Oregon

LINN
11836

Well Record

STATE WELL NO. 13/3W-12H(1)
COUNTY Linn
APPLICATION NO. GR-255

OWNER: Frank W. Cochran & Harold Shelton

MAILING
ADDRESS:

LOCATION OF WELL: Owner's No. 1


CITY AND
STATE:

Brownsville, Oregon

SE 1/4 NE 1/4 Sec. 12 T. 13 N. S. R. 3 W., W.M.

Bearing and distance from section or subdivision

corner N. 0° 34' E. 91.30 chs. from E 1/4 cor. Sec. 13

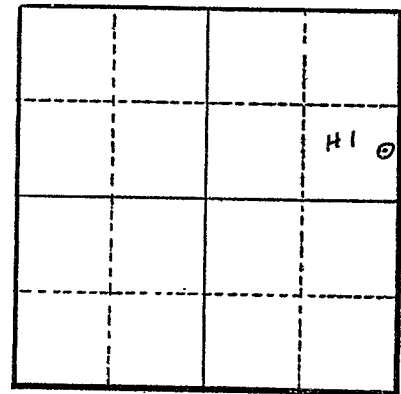

Altitude at well 300 ft. Interpolated

TYPE OF WELL: drilled Date Constructed 7/20/52

Depth drilled 30 ft. Depth cased 20 ft.

Section 12

CASING RECORD: 8 inch casing set from 0 to 20 ft.

FINISH: unknown

AQUIFERS: Sandy shale 27 to 30 ft.

WATER LEVEL: 10 ft. below land surface

PUMPING EQUIPMENT: Type Myers jet H.P. 2
Capacity 40 G.P.M.

WELL TESTS:
Drawdown 12 ft. after hours pumping 60 G.P.M.
Drawdown ft. after hours G.P.M.

USE OF WATER irrigation 1 acre Temp. °F. 19

SOURCE OF INFORMATION Reg. St. GR-255

DRILLER or DIGGER

ADDITIONAL DATA:

Log X Water Level Measurements Chemical Analysis Aquifer Test

REMARKS: Log: Clay, dense 0 to 10 ft.
Shale 10 to 27 ft.
Shale, sandy 27 to 30 ft.