

STATE ENGINEER
Salem, Oregon

LINN
11837

Well Record

STATE WELL NO. 13/3W-12P(1)
COUNTY Linn
APPLICATION NO. GR-257

OWNER: Frank W. Cochran

MAILING
ADDRESS:

LOCATION OF WELL: Owner's No. 3


CITY AND
STATE:

Brownsville, Oregon

SE 1/4 SW 1/4 Sec. 12 T. 13 N. 3 S. R. 3 W., W.M.

Bearing and distance from section or subdivision

corner N. 47° 01' E. 66/78 chs. from E $\frac{1}{4}$ cor. Sec. 13

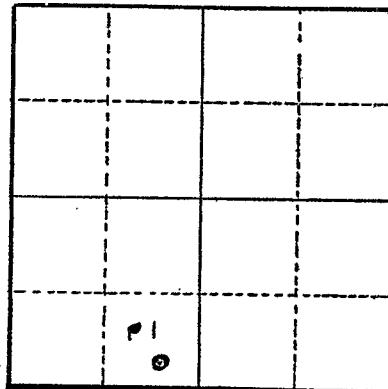

Section 12

Altitude at well 300 ft. Interpolated

TYPE OF WELL: drilled Date Constructed 8/20/48

Depth drilled 72 ft. Depth cased 67 ft.

CASING RECORD: 8 inch casing set from 0 to 67 ft.

FINISH: Slot perforations set from 40 to 67 ft.

AQUIFERS: Sand from 18 to 36 ft. & sandy shale from 53 to 71 ft.

WATER LEVEL: 20 ft. below land surface

PUMPING EQUIPMENT: Type Peerless turbine H.P. 3
Capacity 75 G.P.M.

WELL TESTS:

Drawdown 72 ft. after _____ hours pumping 75 G.P.M.

Drawdown _____ ft. after _____ hours _____ G.P.M.

USE OF WATER irrigation 20 acres Temp. _____ °F. _____, 19

SOURCE OF INFORMATION Reg. St. GR-257

DRILLER or DIGGER _____

ADDITIONAL DATA:

Log X Water Level Measurements _____ Chemical Analysis _____ Aquifer Test _____

REMARKS:

State Well No. 13/3W-12P(1)

County Linn

Application No.GR-257.....

Well Log

Owner: Frank W. Cochran

Owner's No. 3

Driller: _____ Date Drilled 8/20/48

[illegible]