

STATE ENGINEER
Salem, Oregon

LINN
11846

OBSERVATION WELL
Well Record

STATE WELL NO. 13/3W-13A(2)
COUNTY Linn
APPLICATION NO. GR-256

OWNER: Frank W. Cochran

MAILING
ADDRESS:

LOCATION OF WELL: Owner's No. 2


CITY AND
STATE:

Brownsville, Oregon

NE 1/4 NE 1/4 Sec. 13 T. 13 N. S. R. 3 E. W. W.M.

Bearing and distance from section or subdivision

corner N. 0° 12' E. 34.17 chs. from E1 cor. Sec. 13

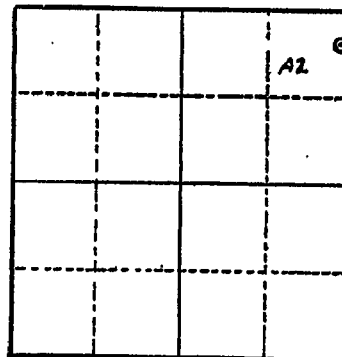

Altitude at well 400 ft. Interpolated

TYPE OF WELL: drilled Date Constructed 8/20/51

Depth drilled 103 ft. Depth cased 103 ft.

Section 13

CASING RECORD: 6 inch casing set from 0 to 103 ft.

FINISH: Slots set from 91 to 103 ft.

AQUIFERS: Gravel and sand from 32 to 95 ft.

WATER LEVEL: 18 ft. below land surface 8/27/51

PUMPING EQUIPMENT: Type Myers jet H.P. 2
Capacity 40 G.P.M.

WELL TESTS:

Drawdown 70 ft. after hours pumping 10 G.P.M.

Drawdown ft. after hours G.P.M.

USE OF WATER irrigation 1 acre Temp. °F. 19

SOURCE OF INFORMATION Reg. St. GR-256

DRILLER or DIGGER

ADDITIONAL DATA:

Log X Water Level Measurements Chemical Analysis Aquifer Test

REMARKS:

377
LINN.
11846

Application No. GR-256

Driller: _____ Date Drilled 8/20/51

[illegible]