

STATE ENGINEER
Salem, Oregon

LINN
11847

Well Record

STATE WELL NO. 13/3W-13C(1)
COUNTY Linn
APPLICATION NO. GR-257

OWNER: Frank W. Cochran

MAILING
ADDRESS:

LOCATION OF WELL: Owner's No. 4


CITY AND
STATE:

Brownsville, Oregon

NE 1/4 NW 1/4 Sec. 13 T. 13 N. E.
S. R. 3 W. W.M.

Bearing and distance from section or subdivision

corner N. 51° 27' E. 62.07 chs. from E1/4 cor. Sec. 13

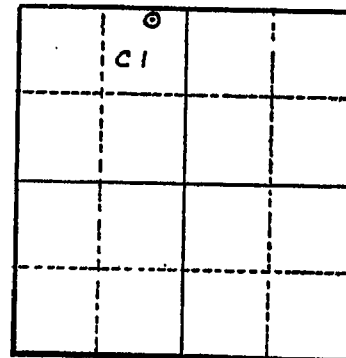

Section 13

Altitude at well 300 ft. Interpolated

TYPE OF WELL: drilled Date Constructed 8/17/50

Depth drilled 74 ft. Depth cased 66 ft.

CASING RECORD: 8 inch steel casing set from 0 to 66 ft.

FINISH: Slot perforations set between 30 and 66 ft.

AQUIFERS: gravel 30 to 33 ft. - sandy shale tl to 65 ft.

WATER LEVEL: 33 ft. below land surface Aug. 30, 1950

PUMPING EQUIPMENT: Type Peerless 11 stage turbine H.P. 5
Capacity 100 G.P.M.

WELL TESTS:
Drawdown 50 ft. after hours pumping 150 G.P.M.
Drawdown ft. after hours G.P.M.

USE OF WATER irrigation 20 acres Temp. °F. 19

SOURCE OF INFORMATION Reg. St. GR-257

DRILLER or DIGGER

ADDITIONAL DATA:

Log X Water Level Measurements Chemical Analysis Aquifer Test

REMARKS: See GR-255 for map.

378
LINN
11847

Well Log

Driller: _____ Date Drilled 8/17/50[illegible]