

STATE ENGINEER
Salem, Oregon

LINN
11850

Well Record

STATE WELL NO. 13/3W-15G(1)
COUNTY Linn
APPLICATION NO. GR-410

OWNER: Fred & Ida G. Glaser

MAILING

ADDRESS:

LOCATION OF WELL: Owner's No.


CITY AND

STATE: Shedd, Oregon

SW 1/4 NE 1/4 Sec. 15 T. 13 S. R. 3 E. W., W.M.

Bearing and distance from section or subdivision

corner N. 43° 25' W. 56 chs. from SE cor. Sec. 15

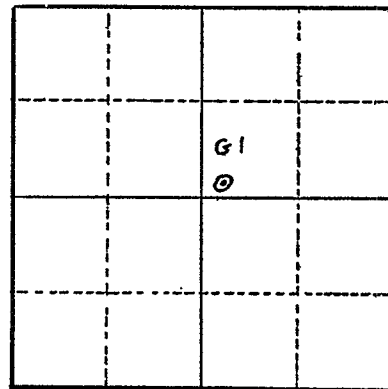

Altitude at well 272 ft.

TYPE OF WELL: drilled Date Constructed 12/30/50

Depth drilled 141 ft. Depth cased 141 ft.

Section 15

CASING RECORD: 8 inch

FINISH:

AQUIFERS:

WATER LEVEL: 14 ft.

PUMPING EQUIPMENT: Type H.P.
Capacity G.P.M.

WELL TESTS:

Drawdown ft. after hours G.P.M.

Drawdown ft. after hours G.P.M.

USE OF WATER irrigation 15 acres Temp. °F. 19.

SOURCE OF INFORMATION GR-410

DRILLER or DIGGER T. J. Burkhart; Termonton, Utah

ADDITIONAL DATA:

Log Water Level Measurements Chemical Analysis Aquifer Test

REMARKS: