

STATE ENGINEER
Salem, Oregon

LINN
11851

Well Record

STATE WELL NO. 13/3W-16N
COUNTY Linn
APPLICATION NO. CR-3710

OWNER: Hattie Quimby

MAILING
ADDRESS:

LOCATION OF WELL: Owner's No.

CITY AND
STATE:

Halsey, Oregon

SW $\frac{1}{4}$ SE $\frac{1}{4}$ Sec. 16 T. 13 S., R. 3 W., W.M.


Bearing and distance from section or subdivision

corner N. 1250' E. 90' from SW cor. Sec. 16

Altitude at well

TYPE OF WELL: Drilled Date Constructed 1948

Depth drilled 50 feet Depth cased 50 feet

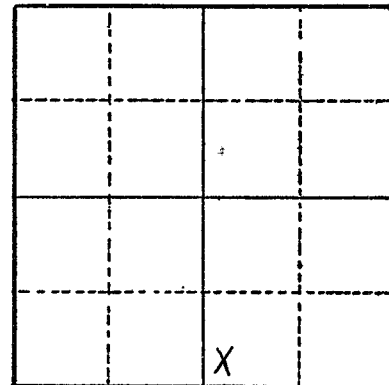

Section 16

CASING RECORD:

10 inch casing set to 50 feet

FINISH:

slotted perforations $\frac{1}{4}$ " x 6" 5 or 6 per foot

AQUIFERS:

WATER LEVEL:

9 feet below surface

PUMPING EQUIPMENT: Type Fairbanks Morse depp well turbine H.P. 5
Capacity 100 G.P.M.

WELL TESTS:

Drawdown 25 ft. after 75 hours G.P.M.

Drawdown ft. after hours G.P.M.

USE OF WATER Irrigation Temp. °F., 19

SOURCE OF INFORMATION Wall Registration Statement

DRILLER or DIGGER Art Clinton

ADDITIONAL DATA:

Log Water Level Measurements Chemical Analysis Aquifer Test

REMARKS: