

STATE ENGINEER
Salem, Oregon

LINN
11866

Well Record

STATE WELL NO. 13/3W-18E(1)
COUNTY Linn
APPLICATION NO. GR-278

OWNER: John Pugh & Son

MAILING

ADDRESS: 1 1/4 mile south of

LOCATION OF WELL: Owner's No. 1


CITY AND

STATE: Shedd, Oregon

SW 1/4 NW 1/4 Sec. 18 T. 13 N. S. R. 3 W., W.M.

Bearing and distance from section or subdivision

corner N. 37° 30' E. 7.5 chs. from SW cor. NW 1/4
Sec. 18

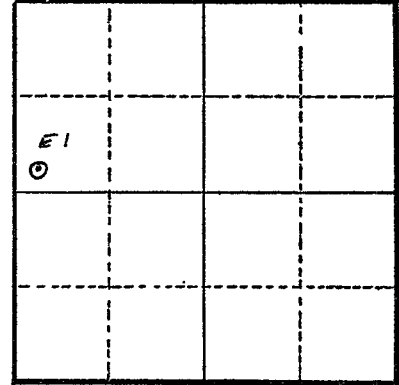

Altitude at well 265 ft. Interpolated

TYPE OF WELL: drilled Date Constructed 4/14/52

Depth drilled 157 ft. Depth cased 157 ft.

Section 18

CASING RECORD: 8 inch open end casing set from 0 to 157 ft.

FINISH: Mills knife slots from 36 to 40 ft.
70 to 75 ft.
Torch cut slots from 105 to 128 ft.
137 to 157 ft.

AQUIFERS: Sand and gravel from 33 to 75 ft.
110 to 125 ft.
142 to 155 ft.

WATER LEVEL: 12 ft. below land surface

PUMPING EQUIPMENT: Type Fairbanks Morse Pomona turbine H.P. 7 1/2
Capacity 150 G.P.M.

WELL TESTS:
Drawdown 65 ft. after hours pumping 135 G.P.M.
Drawdown ft. after hours G.P.M.

USE OF WATER irrigation 20 acres Temp. °F. 19

SOURCE OF INFORMATION Reg. St. GR-278

DRILLER or DIGGER

ADDITIONAL DATA:

Log ☒ Water Level Measurements Chemical Analysis Aquifer Test

REMARKS:

State Well No. 13/3W-18E(1)

County Linn

Application No. GR-278

Well Log

Owner: John Pugh & Son

Owner's No. 1

Driller:

Date Drilled 4/14/52

[illegible]