

STATE ENGINEER
Salem, Oregon

LINN
11870

Well Record

GR- 1410

STATE WELL NO. 13/3W-19P
COUNTY Linn
APPLICATION NO. GR- 1461

OWNER: Elizabeth McCord Salmon

MAILING
ADDRESS:

LOCATION OF WELL: Owner's No.


CITY AND
STATE:

Halsey, Oregon

SE 1/4 SW 1/4 Sec. 19 T. 13 S. R. 3 W. W.M.

Bearing and distance from section or subdivision

corner N. 64° 10' W. 13.5 ch. from SE cor. of SW 1/4
of Sec. 19.

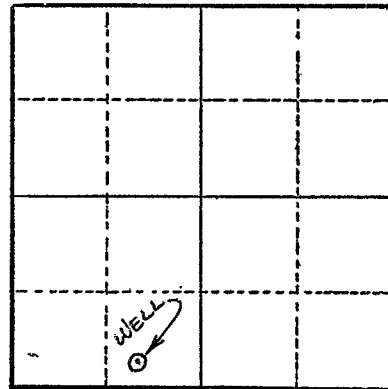

Section 19

Altitude at well 269'

TYPE OF WELL: Drilled Date Constructed 1948

Depth drilled 35' Depth cased 35'

CASING RECORD:

8"

FINISH:

Slot perforations from 27' to 35'

AQUIFERS:

WATER LEVEL:

9'

PUMPING EQUIPMENT: Type 2 1/2" Stout H.P. 3
Capacity 45 G.P.M.

WELL TESTS:

Drawdown 20 ft. after 45 hours G.P.M.

Drawdown ft. after hours G.P.M.

USE OF WATER Irrigation Temp. °F., 19

SOURCE OF INFORMATION GR Record

DRILLER or DIGGER Bill Hamilton

ADDITIONAL DATA:

Log N.A. Water Level Measurements Chemical Analysis Aquifer Test

REMARKS:

Irrigation of 8.7 acres