

STATE ENGINEER
Salem, Oregon

LINN
11970

Well Record

STATE WELL NO. 13/3W-3LL(1)
COUNTY Linn
APPLICATION NO. GR-101

OWNER: Clarence H. Williams


MAILING
ADDRESS: Box 235

LOCATION OF WELL: Owner's No. 1

CITY AND
STATE: Halsey, Oregon

NE $\frac{1}{4}$ SW $\frac{1}{4}$ Sec. 31 T. 13 S., R. 3 W., W.M.

Bearing and distance from section or subdivision
corner

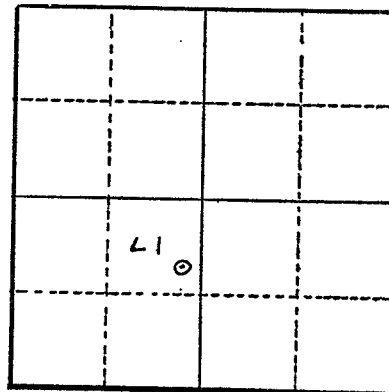

Section 31

Altitude at well 280 ft. Interpolated

TYPE OF WELL: drilled Date Constructed 9/15/47

Depth drilled 135 ft. Depth cased 135 ft.

CASING RECORD: 6 inch casing set from 0 to 135 ft.

FINISH: Perforations from
20 to 35 ft.
45 to 60 ft.
75 to 90 ft.

AQUIFERS: unknown

WATER LEVEL: 16 ft. below land surface Sept. 1953

PUMPING EQUIPMENT: Type Pacific pump turbine H.P. 7 $\frac{1}{2}$
Capacity 140 G.P.M.

WELL TESTS:

Drawdown 18 ft. after 135 hours G.P.M.
Drawdown 16 ft. after 140 hours G.P.M.

USE OF WATER irrigation Temp. °F. 19

SOURCE OF INFORMATION Reg. St. GR-101

DRILLER or DIGGER Cubbison; Brownsville, Oregon

ADDITIONAL DATA:

Log Water Level Measurements Chemical Analysis Aquifer Test

REMARKS: