

STATE ENGINEER  
Salem, Oregon

LINN  
11983

# Well Record

STATE WELL NO. 13/3W-34Q(1)  
COUNTY Linn  
APPLICATION NO. GR-58

OWNER: James C. and Betty A. Barnes


MAILING ADDRESS: \_\_\_\_\_

LOCATION OF WELL: Owner's No. 1

CITY AND STATE: Halsey, Oregon

SW 1/4 SE 1/4 Sec. 34 T. 13 N. S. R. 3 E. W., W.M.

Bearing and distance from section or subdivision  
corner 25 chs. E. of SW cor. DLC Charles Rice

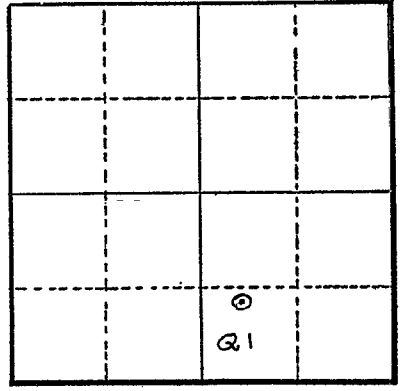

Section 34

Altitude at well 290 ft. Interpolated

TYPE OF WELL: drilled Date Constructed July 1954

Depth drilled 77 ft. Depth cased 74 ft.

CASING RECORD: 8 inch casing set from 0 to 74 ft.

FINISH: Torch cut slots from 64 to 74 ft.

AQUIFERS: Gravel from 35 to 77 ft.

WATER LEVEL: 12 ft. below land surface

PUMPING EQUIPMENT: Type Fairbanks Morse turbine H.P. 10  
Capacity 180 G.P.M.

WELL TESTS:

Drawdown	45	ft. after	hours	100	G.P.M.
Drawdown	60	ft. after	hours	200	G.P.M.

USE OF WATER irrigation 52 acres Temp. °F. 19

SOURCE OF INFORMATION Reg. St. GR-58

DRILLER or DIGGER

ADDITIONAL DATA:  
Log X Water Level Measurements Chemical Analysis Aquifer Test

REMARKS:

