

STATE ENGINEER  
Salem, Oregon

**LINN**  
11990

# Well Record


STATE WELL NO. 13/3W-36C  
COUNTY Linn  
APPLICATION NO. GR-3243

OWNER: Marvin A. and Elizabeth A. Lincoln Mailing ADDRESS: Route 1, Box 292

LOCATION OF WELL: Owner's No. CITY AND STATE: Brownsville, Oregon

NE 1/4 NW 1/4 Sec. 36 T. 13 N. S., R. 3 E. W., W.M.

Bearing and distance from section or subdivision corner 528' S. and 1650' E. of the N.W. corner of Section 36

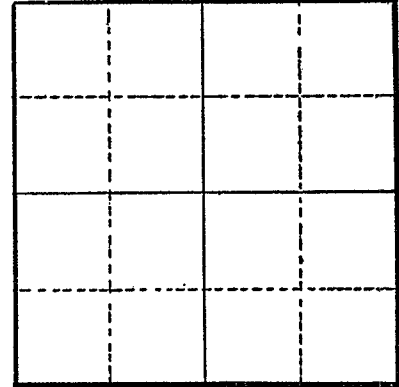

Section

Altitude at well

TYPE OF WELL: drilled Date Constructed 1953

Depth drilled 40 Depth cased

### CASING RECORD:

12 inch

### FINISH:

### AQUIFERS:

### WATER LEVEL:

PUMPING EQUIPMENT: Type Centrifugal H.P. 5  
Capacity G.P.M.

WELL TESTS:  
Drawdown ft. after hours G.P.M.  
Drawdown ft. after hours G.P.M.

USE OF WATER Irrigation Temp. °F., 19

SOURCE OF INFORMATION GR-3018

DRILLER or DIGGER

ADDITIONAL DATA:  
Log Water Level Measurements Chemical Analysis Aquifer Test

### REMARKS: