

STATE ENGINEER
Salem, Oregon

LINN
12006

Well Record

STATE WELL NO. 13/4W-3B(1)
COUNTY Linn
APPLICATION NO. GR-759

OWNER: R. W. Brown

MAILING

ADDRESS: Rt. 1

LOCATION OF WELL: Owner's No. 1

CITY AND


STATE: Shedd, Oregon

NW 1/4 NE 1/4 Sec. 3 T. 1e S. R. 4 W., W.M.

Bearing and distance from section or subdivision

corner 18.5 chs. S. 64° 15' E. from NW cor. NE 1/4

Sec. 3

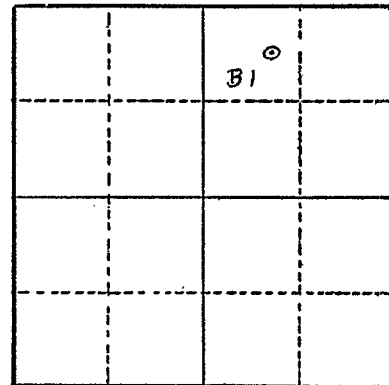

Section 3

Altitude at well 252 ft. Interpolated

TYPE OF WELL: drilled Date Constructed 9/14/51

Depth drilled 121 ft. Depth cased 121 ft.

CASING RECORD: 8 inch

FINISH: Slot perforations from 37 to 57 ft.
95 to 121 ft.

AQUIFERS:

WATER LEVEL:

PUMPING EQUIPMENT: Type Elec. Pamona turbine H.P. 5
Capacity 150 G.P.M.

WELL TESTS:

Drawdown 30 ft. after 200 hours G.P.M.

Drawdown ft. after hours G.P.M.

USE OF WATER irrigation Temp. °F. 19

SOURCE OF INFORMATION GR-759

DRILLER or DIGGER

ADDITIONAL DATA:

Log X Water Level Measurements Chemical Analysis Aquifer Test

REMARKS:

State Well No. 13/4W-3B(1)

County Linn

Application No. GR-759

Well Log

Owner: R. W. Brown

Owner's No. 1

Driller: _____ Date Drilled Sept. 14, 1951

[illegible]