

STATE ENGINEER
Salem, Oregon

LINN
12007

Well Record

GR- 958

STATE WELL NO. 13/4W-3B(2)
COUNTY Linn
APPLICATION NO. GR- 989

OWNER: J. W. & Mary Brown

MAILING

ADDRESS: Rt. 1, Box 16

LOCATION OF WELL: Owner's No.

CITY AND


STATE: Shedd, Oregon

NW 1/4 NE 1/4 Sec. 3 T. 13 S., R. 4 W., W.M.

Bearing and distance from section or subdivision

corner S47°15'E. 8.75 ch. from NW cor. of NE 1/4 of

Section 3.

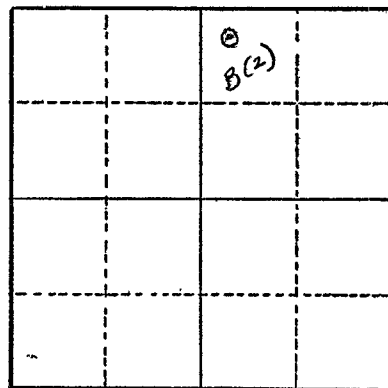

Altitude at well 257 ft.

TYPE OF WELL: Drilled Date Constructed 1950

Depth drilled 120 ft. Depth cased 120 ft.

Section 3

CASING RECORD:

8 inch

FINISH:

Slot perforations from 66 to 75 ft.

" " " 94 to 120 ft.

AQUIFERS:

WATER LEVEL:

25 ft.

PUMPING EQUIPMENT: Type Jacuzzi deep well H.P. 5

Capacity 150 G.P.M.

WELL TESTS:

Drawdown 10 ft. after 125 hours G.P.M.

Drawdown ft. after hours G.P.M.

USE OF WATER Irrigation Temp. °F., 19

SOURCE OF INFORMATION G.R. Record

DRILLER or DIGGER

ADDITIONAL DATA:

Log X Water Level Measurements Chemical Analysis Aquifer Test

REMARKS:

Irrigation of 24.5 acres.

State Well No. 13/4W-3B(2)
County Linn
Application No. _____

Owner: J. W. & Mary Brown Owner's No.

Driller: _____ Date Drilled 1950

[illegible]