

OWNER: Harvey Reeser


MAILING ADDRESS: Rt. 2

LOCATION OF WELL: Owner's No. 1

CITY AND STATE: Foster, Oregon

SW 1/4 NW 1/4 Sec. 25 T. 13 N. S., R. 1 E. W., W.M.

Bearing and distance from section or subdivision corner N. 45° 20' E. 15.70 chs. from SW cor. NW 1/4 Sec. 25

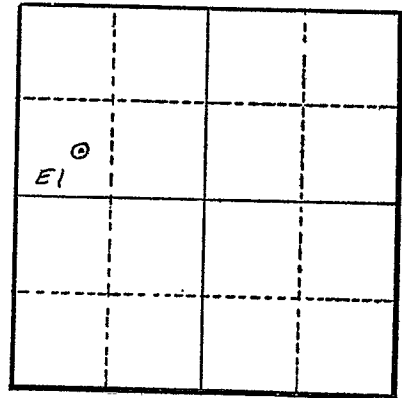

Section 25

Altitude at well 570 ft. Interpolated

TYPE OF WELL: drilled Date Constructed 6/7/55

Depth drilled 75 ft. Depth cased 44 1/2 ft.

CASING RECORD: 6 inch casing set from 0 to 44.5 ft.

FINISH: none

AQUIFERS: unknown ? light shale?

WATER LEVEL: 15 ft. below land surface

PUMPING EQUIPMENT: Type Montgomery Ward jet H.P. 2  
Capacity 25 G.P.M.

WELL TESTS:  
Drawdown 25 ft. after hours pumping 25 G.P.M.  
Drawdown ft. after hours G.P.M.

USE OF WATER irrigation 4.7 acres Temp. °F. 19

SOURCE OF INFORMATION Reg. St. GR-166

DRILLER or DIGGER

ADDITIONAL DATA:

Log  Water Level Measurements Chemical Analysis Aquifer Test

REMARKS: Log: Sand and river fill 0 to 44 ft.  
Light shale 44 to 75 ft.