

STATE OF OREGON
WATER WELL REPORT
(as required by ORS 537.765)

(1) OWNER: Well Number: _____
Name Roger George
Address 41238 Manitau Rd SE
City Stayton State OR Zip 97383

(2) TYPE OF WORK:

☐ New Well ☒ Deepen ☐ Recondition ☐ Abandon

(3) DRILL METHOD

☒ Rotary Air ☐ Rotary Mud ☐ Cable

☐ Other _____

(4) PROPOSED USE:

☒ Domestic ☐ Community ☐ Industrial ☐ Irrigation

☐ Thermal ☐ Injection ☐ Other _____

(5) BORE HOLE CONSTRUCTION:

Special Construction approval Yes No Depth of Completed Well 309 ft.

Explosives used Yes No Type Amount

HOLE			SEAL			Amount sacks or pounds
Diameter	From	To	Material	From	To	
5 13/16	198	309	Original seal			

How was seal placed: Method ☐ A ☐ B ☐ C ☐ D ☐ E

☐ Other _____

Backfill placed from _____ ft. to _____ ft. Material _____

Gravel placed from _____ ft. to _____ ft. Size of gravel _____

(6) CASING/LINER:

	Diameter	From	To	Gauge	Steel	Plastic	Welded	Threaded
Casing:	6"	+1	19	.250	☒	☐	☒	☐
	Original				☐	☐	☐	☐
Liner:					☐	☐	☐	☐

Final location of shoe(s) _____

(7) PERFORATIONS/SCREENS:

☐ Perforations Method _____
☐ Screens Type _____ Material _____

From	To	Slot size	Number	Diameter	Tele/pipe size	Casing	Liner
						☐	☐
						☐	☐
						☐	☐
						☐	☐
						☐	☐
						☐	☐

(8) WELL TESTS: Minimum testing time is 1 hour

☐ Pump ☐ Bailor ☒ Air ☐ Flowing Artesian

Yield gal/min	Drawdown	Drill stem at	Time
25		307	1 hr.

Temperature of water 60+ ° Depth Artesian Flow Found _____

Was a water analysis done? ☐ Yes By whom _____

Did any strata contain water not suitable for intended use? ☐ Too little

☐ Salty ☐ Muddy ☐ Odor ☐ Colored ☐ Other _____

Depth of strata: _____

(9) LOCATION OF WELL by legal description:

County Linn Latitude _____ Longitude _____
Township 9 S N of S. Range 1 W E or W, WM.
Section 24 SW NW 1/4
Tax Lot #0370177 Parcel #00107 Block _____ Subdivision _____
Street Address of Well (or nearest address) _____
Same as #1.

(10) STATIC WATER LEVEL:

189 ft. below land surface. Date 8/28/90

Artesian pressure _____ lb. per square inch. Date _____

(11) WATER BEARING ZONES:

Depth at which water was first found 209-229

From	To	Estimated Flow Rate	SWL
249	269	10	
269	289	25gpm total	189'

(12) WELL LOG:

Ground elevation approx 610'

Material	From	To	SWL
Basalt grey hard fx porous	198	218	
Basalt grey hard	218	234	
Basalt grey porous seamy	234	245	
Basalt black/grey porous	245	295	
Claystone grey hard	295	309	189'

RECEIVED

SEP - 4 1990

WATER RESOURCES DEPT.
SALEM, OREGON

Date started 8/27/90 Completed 8/28/90

(unbonded) Water Well Constructor Certification:


I certify that the work I performed on the construction, alteration, or abandonment of this well is in compliance with Oregon well construction standards. Materials used and information reported above are true to my best knowledge and belief.

Signed Donald Stadel WWC Number 1222
Date 8/28/90

(bonded) Water Well Constructor Certification:


I accept responsibility for the construction, alteration, or abandonment work performed on this well during the construction dates reported above. All work performed during this time is in compliance with Oregon well construction standards. This report is true to the best of my knowledge and belief.

Signed Paul R. Stadel WWC Number 296
Date 2/30/90

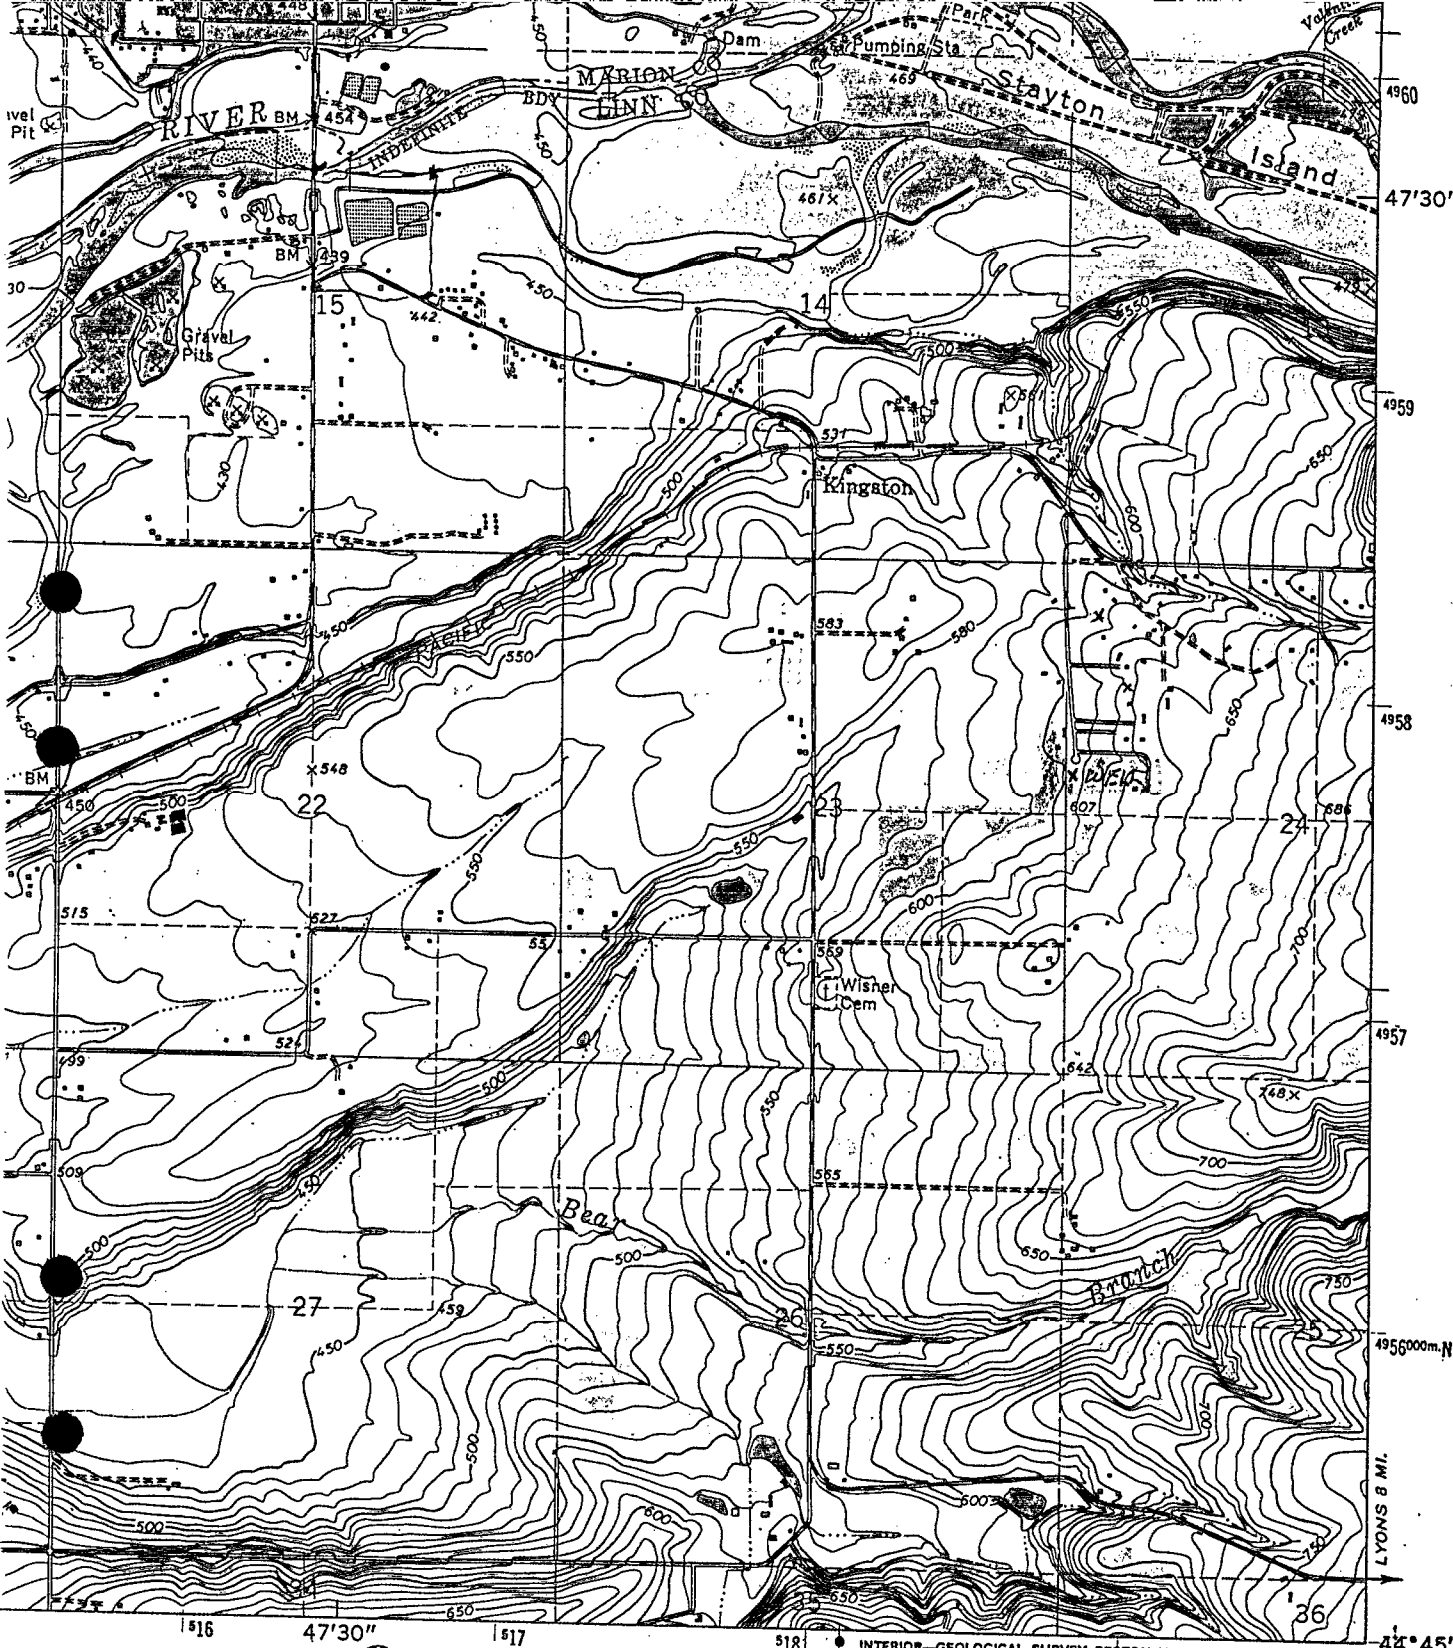

Roger & Jan George
 T.9S, R.1W, sec 24
 S.W 1/4 of N.W. 1/4
 Linn County
 OREGON
 1929

RECEIVED
 Y STANDARDS
 25, OR RESTON, VIRGINIA 22092
 AVAILABLE ON REQUEST

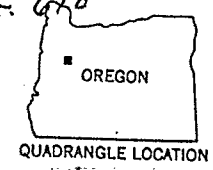

ROAD CLASSIFICATION
 Primary highway, all weather, hard surface
 Secondary highway, all weather, hard surface
 Light-duty road, all weather, improved surface
 Unimproved road, fair or dry weather
 State Route

STAYTON, OREG.
 SE/4 STAYTON 15' QUADRANGLE
 44122-G7-TF-024

Revisions shown in purple compiled from aerial photographs taken 1982 and other sources