

STATE ENGINEER  
Salem, Oregon

LINN  
13407

# Well Record

STATE WELL NO. 11/2W-6E(1)  
COUNTY Linn  
APPLICATION NO. GR-99

OWNER: Herman and Lena Kruesi


MAILING ADDRESS: Rt. 1

LOCATION OF WELL: Owner's No. 1

CITY AND STATE: Brownsville, Oregon

NW  $\frac{1}{4}$  SW  $\frac{1}{4}$  Sec. 6 T. 11 <sup>N.</sup> S., R. 2 <sup>E.</sup> W., W.M.

Bearing and distance from section or subdivision corner 1386 ft. N. & 1122 ft. E. of SW cor. Sec. 6

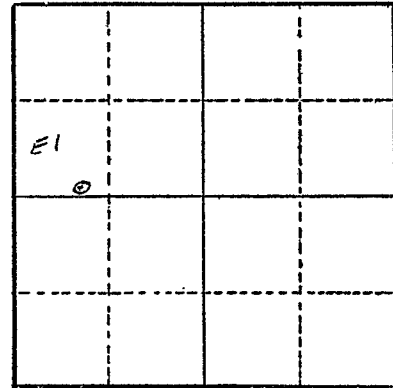

Section 6

Altitude at well 320 ft. Interpolated

TYPE OF WELL: drilled Date Constructed 5/10/48

Depth drilled 83 ft. Depth cased 80 ft.

CASING RECORD: 8 inch steel casing set from 0 to 80 ft.

FINISH: Slit perforations from 20 to 25 ft.  
50 to 55 ft.  
75 to 80 ft.

AQUIFERS: Sand and gravel from 20 to 25 ft.

WATER LEVEL: 6 ft. below land surface (8 ft. in Aug. & Sept.)

PUMPING EQUIPMENT: Type Fairbanks Morse turbine H.P. 10  
Capacity 300 G.P.M.

WELL TESTS:  
Drawdown 65 ft. after 150 hours estimated G.P.M.  
Drawdown          ft. after          hours          G.P.M.

USE OF WATER irrigation 25.3 acres Temp.          °F., 19        

SOURCE OF INFORMATION Reg. St. GR-99

DRILLER or DIGGER         

ADDITIONAL DATA:

Log  Water Level Measurements  Chemical Analysis  Aquifer Test

REMARKS:

