

STATE ENGINEER
Salem, Oregon

LINN
13409

Well Record

GR- 1777

STATE WELL NO. 14/2W-6F
COUNTY Linn
APPLICATION NO. GR- 1832

OWNER: Ray & Barbara Cleland

MAILING

ADDRESS: Rt. 1, Box 435


LOCATION OF WELL: Owner's No. #1

CITY AND

STATE: Albany, Oregon

SE 1/4 NW 1/4 Sec. 6 T. 14 S., R. 2 W., W.M.

Bearing and distance from section or subdivision
corner 1762' S. & 2211' E. from NW cor. Sec. 6

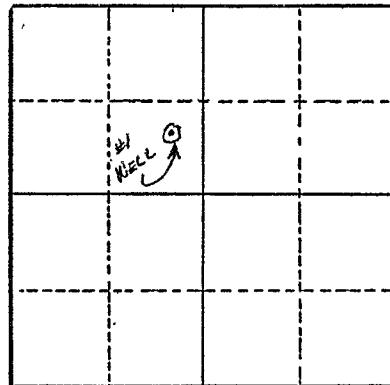

Section 6

Altitude at well 320'

TYPE OF WELL: Drilled Date Constructed 1947

Depth drilled 70' Depth cased 70'

CASING RECORD:

6"

FINISH:

Slot perforations from 20 to 70 ft.

AQUIFERS:

WATER LEVEL:

15'

PUMPING EQUIPMENT: Type Peerless turbine H.P. 5
Capacity 80 G.P.M.

WELL TESTS:

Drawdown ft. after hours G.P.M.
Drawdown ft. after hours G.P.M.

USE OF WATER Irrigation Temp. °F., 19

SOURCE OF INFORMATION GR Record

DRILLER or DIGGER

ADDITIONAL DATA:

Log N.A. Water Level Measurements Chemical Analysis Aquifer Test

REMARKS:

Irrigation of 20 acres.