

STATE ENGINEER
Salem, Oregon

LINN
13426

Well Record

STATE WELL NO. 14/2W-8G
COUNTY LINN
~~APPLICATION NO.~~ GR-2477

OWNER: Emery C. and Jessie O. Nye

MAILING
ADDRESS: Rt. 1, Box 131


LOCATION OF WELL: Owner's No. #1

CITY AND
STATE: Brownsville, Oregon

SW 1/4 NE 1/4 Sec. 8 T. 14 S. R. 2 W., W.M.

Bearing and distance from section or subdivision

corner 2772' N. and 3366' E.

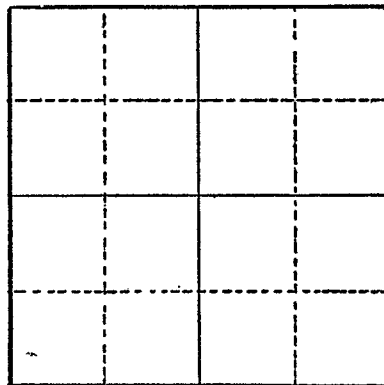

Section

Altitude at well

TYPE OF WELL: Drilled Date Constructed 1951

Depth drilled 54 Depth cased 52

CASING RECORD:

6-inch

FINISH:

AQUIFERS:

WATER LEVEL:

10-feet

PUMPING EQUIPMENT: Type Dorwood Centrifugal H.P. 2
Capacity 48 G.P.M.

WELL TESTS:

Drawdown 32 ft. after hours Pumping 80 G.P.M.

Drawdown ft. after hours G.P.M.

USE OF WATER Irrigation Temp. °F., 19.....

SOURCE OF INFORMATION GR-2346

DRILLER or DIGGER O. B. Nye, Rt. 1, Monroe, Oregon

ADDITIONAL DATA:

Log Water Level Measurements Chemical Analysis Aquifer Test

REMARKS: