

STATE ENGINEER
Salem, Oregon

LINN Well Record


13537

STATE WELL NO. 14/3W-1C
COUNTY Linn
APPLICATION NO. GR-3485

OWNER: Welby A. Schneider
dba Schneider Lumber Company
LOCATION OF WELL: Owner's No. #2

MAILING ADDRESS: P. O. Box 188
CITY AND STATE: Brownsville, Oregon

NE 1/4 NW 1/4 Sec. 1 T. 14 N. S. R. 3 W., W.M.
Bearing and distance from section or subdivision
corner S 41° 10' East 705 feet to the NE
Corner, DLC 38

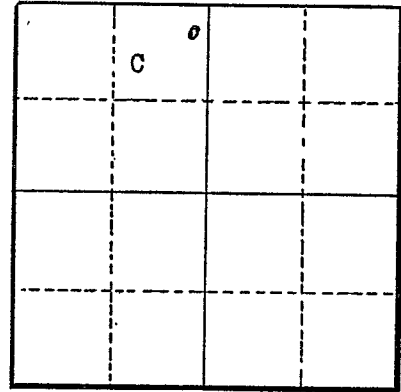

Section 1

Altitude at well 320 feet

TYPE OF WELL: Drilled Date Constructed May 15, 1945

Depth drilled 48 feet Depth cased 48 feet

CASING RECORD:

8-inch casing set from top to 48 feet

FINISH:

AQUIFERS:

WATER LEVEL:

20 feet

PUMPING EQUIPMENT: Type Peerless Pump Model LJ H.P.
Capacity 18 G.P.M.

WELL TESTS:

Drawdown ft. after hours G.P.M.
Drawdown ft. after hours G.P.M.

USE OF WATER Domestic and Industrial Temp. °F., 19

SOURCE OF INFORMATION GR-4092

DRILLER or DIGGER

ADDITIONAL DATA:

Log (NA) Water Level Measurements Chemical Analysis Aquifer Test

REMARKS: