

STATE ENGINEER
Salem, Oregon

LINN
13539

Well Record

STATE WELL NO. 14/3W-1B
COUNTY Linn
APPLICATION NO. GR-3484

OWNER: Welby A. Schneider
dba Schneider Lumber Company


MAILING ADDRESS: P. O. Box 188

LOCATION OF WELL: Owner's No. # 1

CITY AND STATE: Brownsville, Oregon

NW 1/4 NE 1/4 Sec. 1 T. 14 S., R. 3 W., W.M.

Bearing and distance from section or subdivision
corner 241 feet South 38° 32' East to the
NE Corner, DIC 38

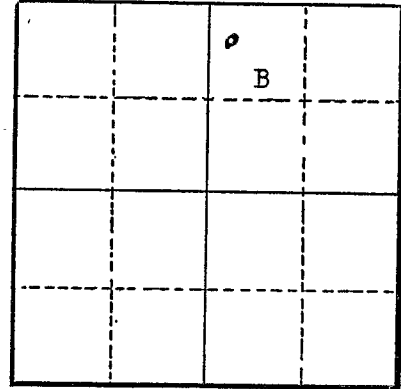

Section 1

Altitude at well 320 feet

TYPE OF WELL: Drilled Date Constructed June 15, 1945

Depth drilled 40 feet Depth cased 40 feet

CASING RECORD:

8-inch casing set from top to 40 feet

FINISH:

AQUIFERS:

WATER LEVEL:

20 feet

PUMPING EQUIPMENT: Type Myers Number HN100 H.P.
Capacity 18 G.P.M.

WELL TESTS:

Drawdown ft. after hours G.P.M.
Drawdown ft. after hours G.P.M.

USE OF WATER see below Temp. °F. , 19

SOURCE OF INFORMATION GR-4091

DRILLER or DIGGER

ADDITIONAL DATA:

Log (NA) Water Level Measurements Chemical Analysis Aquifer Test

REMARKS:

water used for dry kiln boiler and general mill use, also for drinking purposes