

STATE ENGINEER
Salem, Oregon

LINN
13540


Well Record

STATE WELL NO. 14/3W-1C
COUNTY Linn
APPLICATION NO. GR-3486

OWNER: Welby A. Schneider dba
Schneider Lumber Company
LOCATION OF WELL: Owner's No. #3

MAILING ADDRESS: P. O. Box 188
CITY AND STATE: Brownsville, Oregon

NE 1/4 NW 1/4 Sec. 1 T. 14 S., R. 3 W., W.M.
Bearing and distance from section or subdivision
corner 1100 feet South 85°10' East to NE Corner,
DLC 38.

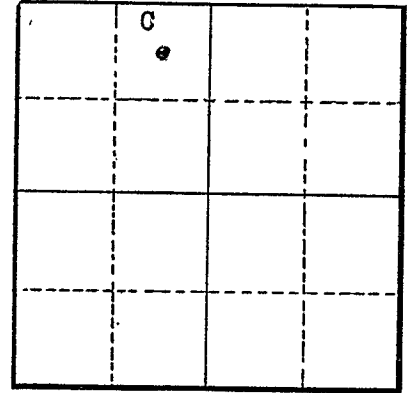

Section 1

Altitude at well 320 feet

TYPE OF WELL: Drilled Date Constructed 6-1-45
Depth drilled 40 feet Depth cased 40 feet

CASING RECORD:

8-inch casing set from top to 40 feet

FINISH:

AQUIFERS:

WATER LEVEL:

20 feet

PUMPING EQUIPMENT: Type Pacific Model N4BF S/N 1CK11241G
Jacuzzi Model 5KC65EB1BX H.P. _____
Capacity 25 G.P.M.

WELL TESTS:

Drawdown _____ ft. after _____ hours _____ G.P.M.
Drawdown _____ ft. after _____ hours _____ G.P.M.

USE OF WATER Industrial Temp. _____ °F. _____, 19____

SOURCE OF INFORMATION GR-4093

DRILLER or DIGGER _____

ADDITIONAL DATA:

Log (NA) Water Level Measurements _____ Chemical Analysis _____ Aquifer Test _____

REMARKS: