

STATE ENGINEER
Salem, Oregon

LINN
13559

Well Record

STATE WELL NO. 14/3W-5R
COUNTY Linn
APPLICATION NO. GR-3655

OWNER: H. R. Bierly

MAILING

ADDRESS: Route 1

CITY AND

STATE: Halsey, Oregon

LOCATION OF WELL: Owner's No.

SE 1/4 SE 1/4 Sec. 5 T. 14 S. R. 3 W., W.M.


Bearing and distance from section or subdivision

corner 462' N. 230' W. of SE cor. Sec. 5

Altitude at well

TYPE OF WELL: Drilled Date Constructed 1950

Depth drilled 28 ft. Depth cased 28 ft.

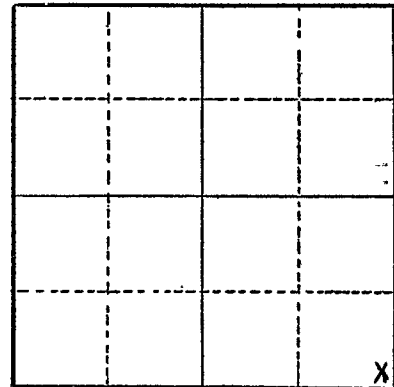

Section 5

CASING RECORD:

8 inch steel casing set to 28 feet

FINISH:

AQUIFERS:

WATER LEVEL:

4 feet below surface

PUMPING EQUIPMENT: Type H.P. 10
Capacity 150 G.P.M.

WELL TESTS:

Drawdown 15 ft. after 90 hours G.P.M.

Drawdown ft. after hours G.P.M.

USE OF WATER Irrigation Temp. °F. 19

SOURCE OF INFORMATION Well Registration Statement

DRILLER or DIGGER C. A. Shafer

ADDITIONAL DATA:

Log Water Level Measurements Chemical Analysis Aquifer Test

REMARKS: