

STATE ENGINEER
Salem, Oregon

LINN
13573

Well Record

STATE WELL NO. 14/3W-6E
COUNTY Linn
APPLICATION NO. GR-3332


OWNER: Eldon F. Cross
MAILING ADDRESS: P.O. Box 216

LOCATION OF WELL: Owner's No. CITY AND STATE: Halsey, Oregon

SW 1/4 NW 1/4 Sec. 6 T. 14 S. R. 3 E. W., W.M.

Bearing and distance from section or subdivision

corner 660' N. & 1254' E. of SW Cor. of NW 1/4 Sec. 6

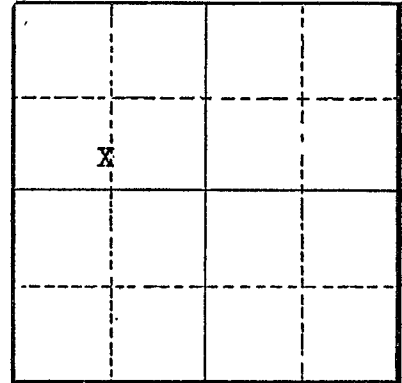

Section 6

Altitude at well

TYPE OF WELL: Drilled Date Constructed 6/20/55

Depth drilled 105 feet Depth cased

CASING RECORD:

FINISH:

AQUIFERS:

WATER LEVEL:

16 feet below surface

PUMPING EQUIPMENT: Type Layne & Bowler H.P. 10
Capacity 250 G.P.M.

WELL TESTS:

Drawdown 14 ft. after 225 hours G.P.M.

Drawdown ft. after hours G.P.M.

USE OF WATER Irrigation Temp. °F. 19

SOURCE OF INFORMATION Well Registration Statement Cert. # GR-3520

DRILLER or DIGGER Bill Hamilton

ADDITIONAL DATA:

Log Water Level Measurements Chemical Analysis Aquifer Test

REMARKS: