

STATE ENGINEER  
Salem, Oregon

**LINN**  
**Well Record**  
**13574**

STATE WELL NO. 14/3W-6E  
COUNTY LINN  
~~APPLICATION NO.~~ GR-2792

OWNER: Patrick J. Dennison

MAILING  
ADDRESS: Halsey, Oregon


LOCATION OF WELL: Owner's No. \_\_\_\_\_

CITY AND  
STATE: \_\_\_\_\_

SW 1/4 NW 1/4 Sec. 6 T. 14 N. 3 E.  
S., R. \_\_\_\_\_ W., W.M.

Bearing and distance from section or subdivision

corner 910' E. and 1340' S.

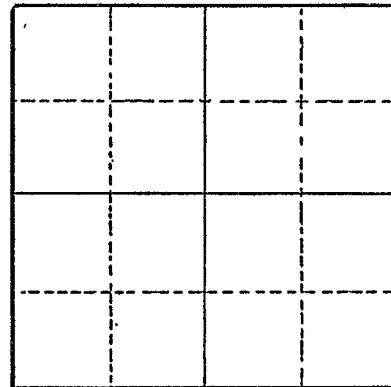

Section \_\_\_\_\_

Altitude at well \_\_\_\_\_

TYPE OF WELL: drilled Date Constructed 1955

Depth drilled 58' Depth cased 254'

CASING RECORD:

4-inch

FINISH:

Perforations from 239 to 227

AQUIFERS:

WATER LEVEL:

8-feet

PUMPING EQUIPMENT: Type Berkeley Pump H.P. 2  
Capacity 35 G.P.M.

WELL TESTS:

Drawdown \_\_\_\_\_ ft. after \_\_\_\_\_ hours \_\_\_\_\_ G.P.M.

Drawdown \_\_\_\_\_ ft. after \_\_\_\_\_ hours \_\_\_\_\_ G.P.M.

USE OF WATER irrigation Temp. \_\_\_\_\_ °F. \_\_\_\_\_, 19 \_\_\_\_\_

SOURCE OF INFORMATION GR-2637

DRILLER or DIGGER Bill Howell, Philomath, Oregon

ADDITIONAL DATA:

Log \_\_\_\_\_ Water Level Measurements \_\_\_\_\_ Chemical Analysis \_\_\_\_\_ Aquifer Test \_\_\_\_\_

REMARKS: