

STATE ENGINEER  
Salem, Oregon

**LINN**  
**13576**

**OBSERVATION WELL**  
**Well Record**

STATE WELL NO. 14/3W-7R(1)  
COUNTY Linn  
APPLICATION NO. GR-184

OWNER: Henry H. and Edna M. Kirk


MAILING ADDRESS: Rt. 1, Box 65

LOCATION OF WELL: Owner's No. 1

CITY AND STATE: Halsey, Oregon

SE 1/4 SE 1/4 Sec. 7 T. 14 N. S., R. 3 E. W., W.M.

Bearing and distance from section or subdivision corner 530' N. & 1090' W. from SE cor. Sec. 7

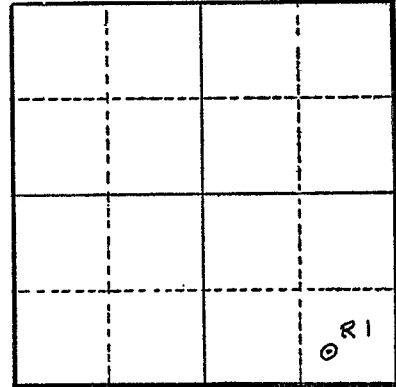

Section 7

Altitude at well 288 ft. Interpolated

TYPE OF WELL: drilled Date Constructed 3/14/53

Depth drilled 123 ft. Depth cased 110 ft.

CASING RECORD: 8 inch casing set from 0 to 110 ft.

FINISH: Mills knife slots set between 35 and 40 ft.  
55 and 60 ft.  
80 and 98 ft.  
98 and 110 ft.

AQUIFERS: Gravels 12 to 30 ft.  
50 to 61 ft.  
95 to 109 ft.

WATER LEVEL: 12 ft. below land surface 3/18/53

PUMPING EQUIPMENT: Type Pamona deep well turbine H.P. 10  
Capacity 180 G.P.M.

WELL TESTS:  
Drawdown 100 ft. after \_\_\_\_\_ hours pumping 230 G.P.M.  
Drawdown \_\_\_\_\_ ft. after \_\_\_\_\_ hours \_\_\_\_\_ G.P.M.

USE OF WATER irrigation 42.06 acres Temp. \_\_\_\_\_ °F. \_\_\_\_\_, 19\_\_\_\_

SOURCE OF INFORMATION Reg. St. GR-184

DRILLER or DIGGER C. A. Schafer; Philomath, Oregon

ADDITIONAL DATA:

Log X Water Level Measurements \_\_\_\_\_ Chemical Analysis \_\_\_\_\_ Aquifer Test \_\_\_\_\_

REMARKS:

